IREDELL COUNTY HEALTH DEPARTMENT Exis. System

STATESVILLE 704-878-5305 MOORESVILLE 704-664-5281

IMPROVEMENT PERMIT / AUTHORIZATION TO CONSTRUCT / OPERATION PERMIT / EXISTING SYSTEM INSPECTION

PERMIT# 144166 PIN# 4658075279 DATE 7/24/07

OWNER OR CONTRACTOR Daniel Thompson PHONE: Business 704-239-6865 Home

ADDRESS 213 Olympia Dr. Mooresville NC 28117

LOCATION Cornelius, TR Olympia, 213 Olympia Dr.

SUBDIVISION Cornelius Estates BLOCK / SECTION LOT 85 LOT AREA .609 SITE CLASS PS DESIGN FLOW 480 L.T.A.R. 0.3

Septic Tank: 1000 Exis Gallons: STB 1012 Date 8/7/04
Pump Tank: Gallons: PT Date
Pump Make: Model Serial No.
Nitrification Field: No Fields 1 Square Feet 1200 Linear Feet 400' Exis.
No Lines 4 Exis. Trench Width 36" Max Trench Bottom Depth 36"

☐ New System ☐ Repair System Type: I (II) III, IV, V, VI
System Description:
Repair System Description: Existing System
Maintenance Agreement Required: ☐ Yes ☐ No


☑ House/Mod. Home No. Bedrooms 4
☐ Mobile Home No. Bathrooms
☐ Business No. Employees
☐ Other
Gravel Depth ☐ Slab ☑ Crawl Space ☐ Basement w/plumbing ☐ Basement wo/plumbing

Water Supply: ☑ Individual ☐ Public ☐ Community


Comments:/Conditions:

Comments:/Conditions: System originally sized for 4BR. App. finishing attic making 4th BR. No visible malfunction observable at time of inspection. See permit 12079 Operation permit "2005"

INITIAL SITE SKETCH

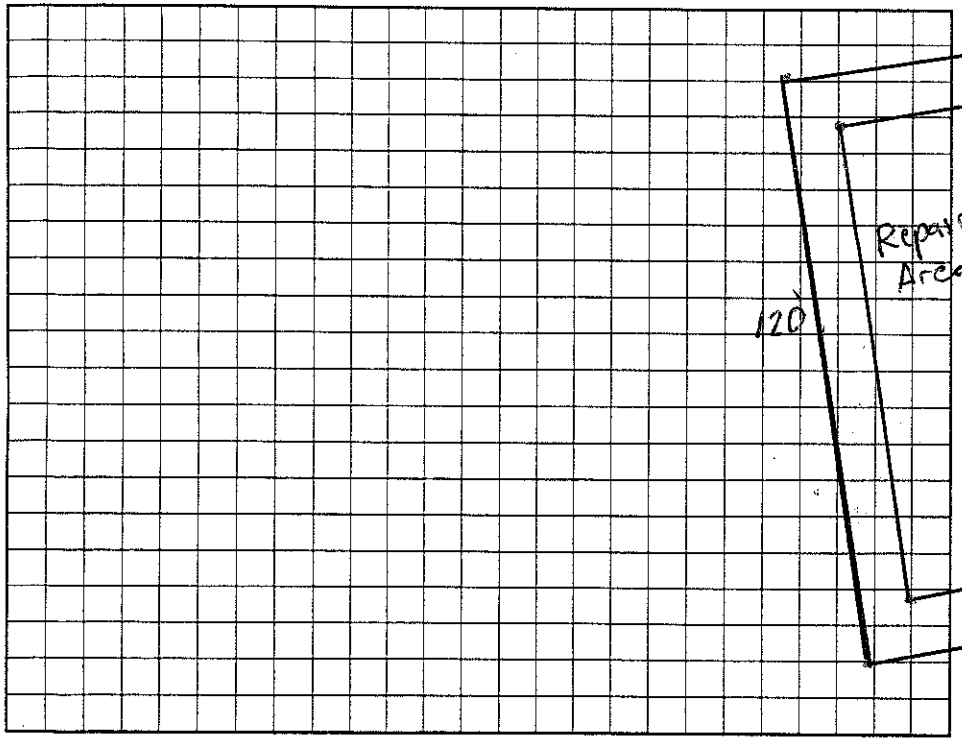

AS BUILT SKETCH

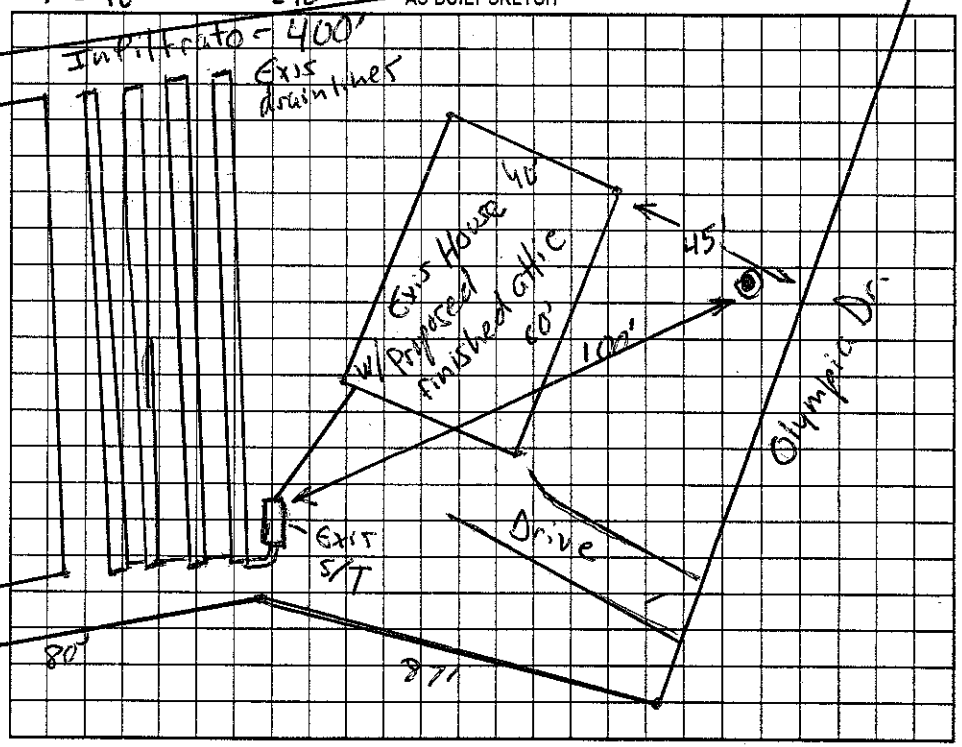

Permit can be suspended or revoked if any false information is supplied toward securing the permit/any unauthorized changes are made to the site/any unauthorized changes are made in the installation of the system. Improvement Permit with plat valid without expiration. Improvement Permit with site plan valid for sixty months. Authorization to Construct is valid for a period equal to that of Improvement Permit – not to exceed sixty months.

Signed: date 7-25-07 Installed by:

Improvement Permit by: date Operation Permit by: date

Authorization to Construct by: date Existing System Inspection by: Anthony Coker Jr. date 7/24/07

HEALTH DEPT. COPY: WHITE OWNER COPY (FINAL): YELLOW OWNER COPY (INITIAL): PINK