IREDELL COUNTY HEALTH DEPARTMENT

STATESVILLE 704-878-5305 — MOORESVILLE 704-664-5281

IMPROVEMENT PERMIT / AUTHORIZATION TO CONSTRUCT / OPERATION PERMIT / EXISTING SYSTEM INSPECTION

D 130.00 Paid 1:30

PERMIT# 120759 PIN# ~~4658-07-3278.077~~ 4658-07-5279 DATE

OWNER OR CONTRACTOR Kim River c/ J.M. Workman Co. PHONE: Business 704 663 2220 Home

ADDRESS 130 Lazy Ln Mooresville NC 28117

LOCATION Cornelius TR Olympia, on Lt Across From Bailey

SUBDIVISION Cornelius Est. BLOCK / SECTION LOT ~~8~~ LOT AREA 0.609 AC SITE CLASS PS DESIGN FLOW 480 L.T.A.R. 0.3

Septic Tank: 1000 Gallons; STB 1012 Date 3/7/04

Pump Tank: Gallons; PT Date

Pump Make: Model Serial No.

Nitrification Field: No Fields 1 Square Feet 1200 Linear Feet 400'

No Lines 4 Trench Width 36" Max Trench Bottom Depth 36" Gravel Depth

☒ New System ☐ Repair System Type: I, II, III, IV, V, VI

System Description: Gravity 25% Reduct.

Repair System Description: Same

Maintenance Agreement Required: ☐ Yes ☒ No

☒ House/Mod. Home No. Bedrooms 4

☐ Mobile Home No. Bathrooms 4

☐ Business No. Employees

☐ Other


☐ Slab ☒ Crawl Space ☐ Basement w/plumbing ☐ Basement wo/plumbing

Water Supply: ☒ Individual ☐ Public ☐ Community


Comments:/Conditions: 1"=40'

Comments:/Conditions:

INITIAL SITE SKETCH 240'

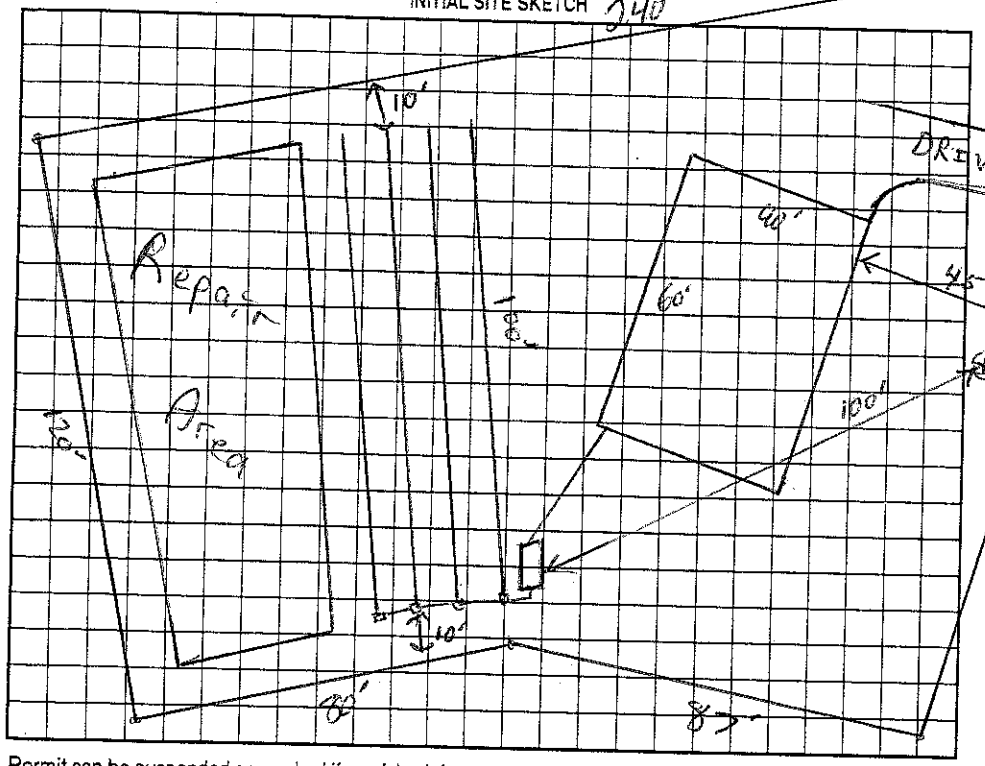

AS BUILT SKETCH

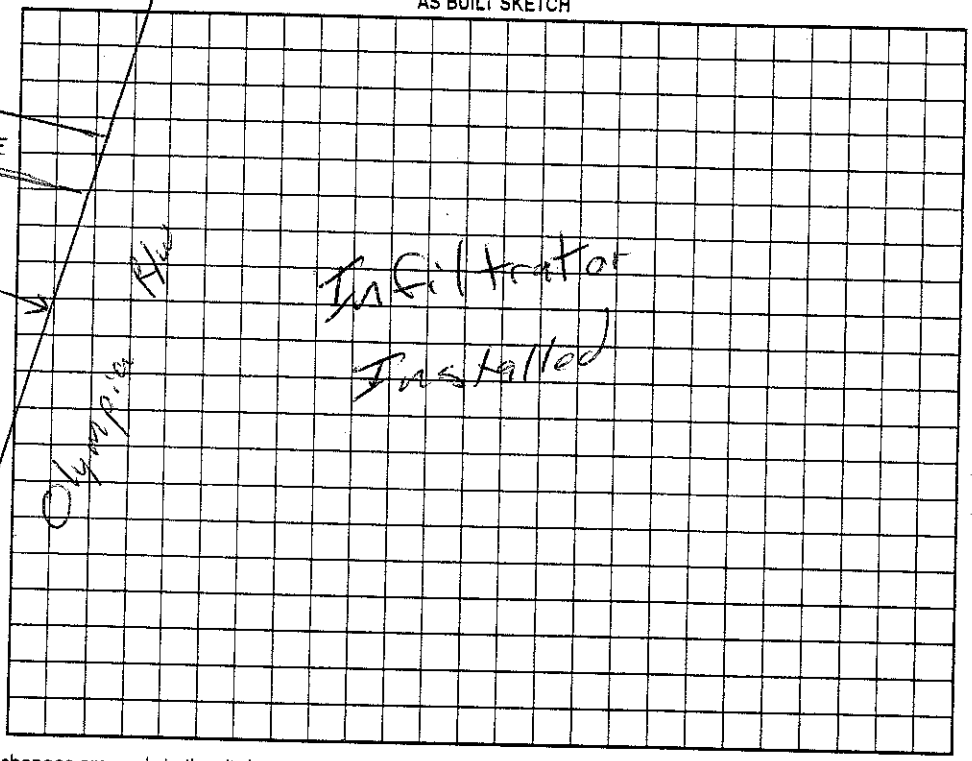

Permit can be suspended or revoked if any false information is supplied toward securing the permit/any unauthorized changes are made to the site/any unauthorized changes are made in the installation of the system. Improvement Permit with plat valid without expiration. Improvement Permit with site plan valid for sixty months. Authorization to Construct is valid for a period equal to that of Improvement Permit – not to exceed sixty months.

Signed: date 2-15-05 Installed by: H-1 Backhoe

Improvement Permit by: RS date 5/29/04 Operation Permit by: RS date 3/3/05

Authorization to Construct by: RS date 2/15/05 Existing System Inspection by: date

HEALTH DEPT. COPY: WHITE OWNER COPY (FINAL): YELLOW OWNER COPY (INITIAL): PINK