IREDELL COUNTY HEALTH DEPARTMENT

STATESVILLE 704-878-5305 MOORESVILLE 704-664-5281

IMPROVEMENT PERMIT / AUTHORIZATION TO CONSTRUCT / OPERATION PERMIT / EXISTING SYSTEM INSPECTION

PERMIT# 120758 PIN# ~~4658-07-3278~~ 4658-07-5474 DATE 5/20/04

OWNER OR CONTRACTOR King Rivera / Panacea Housing Dip. PHONE: Business 704 663 2220 Home

ADDRESS 130 Lazy Ln Mooresville NC 28117

LOCATION Cornelius, TR Olympia, on Lt across from Bailey

SUBDIVISION Cornelius Est BLOCK / SECTION LOT 86 LOT AREA 0.901 AC SITE CLASS. PS DESIGN FLOW 480 L.T.A.R. 0.35

Septic Tank: 1000 Gallons; STB 1012 Date 4/18/04

Pump Tank: Gallons; PT Date

Pump Make: Model Serial No.

Nitrification Field: No Fields 1 Square Feet 1380 Linear Feet 460'

No Lines 4 or 5 Trench Width 36" Max Trench Bottom Depth 36" Gravel Depth 12"

☒ New System ☐ Repair System Type: I, II, III, IV, V, VI

System Description: Gravity Conventional

Repair System Description: 25% Reduction

Maintenance Agreement Required: ☐ Yes ☒ No

☒ House/Mod. Home ☐ Mobile Home ☐ Business ☐ Other

No. Bedrooms 4 No. Bathrooms 4 No. Employees


Water Supply: ☒ Individual ☐ Public ☐ Community

☐ Slab ☒ Crawl Space ☐ Basement w/plumbing ☐ Basement wo/plumbing


Comments:/Conditions: 1"=40'

Comments:/Conditions:

INITIAL SITE SKETCH

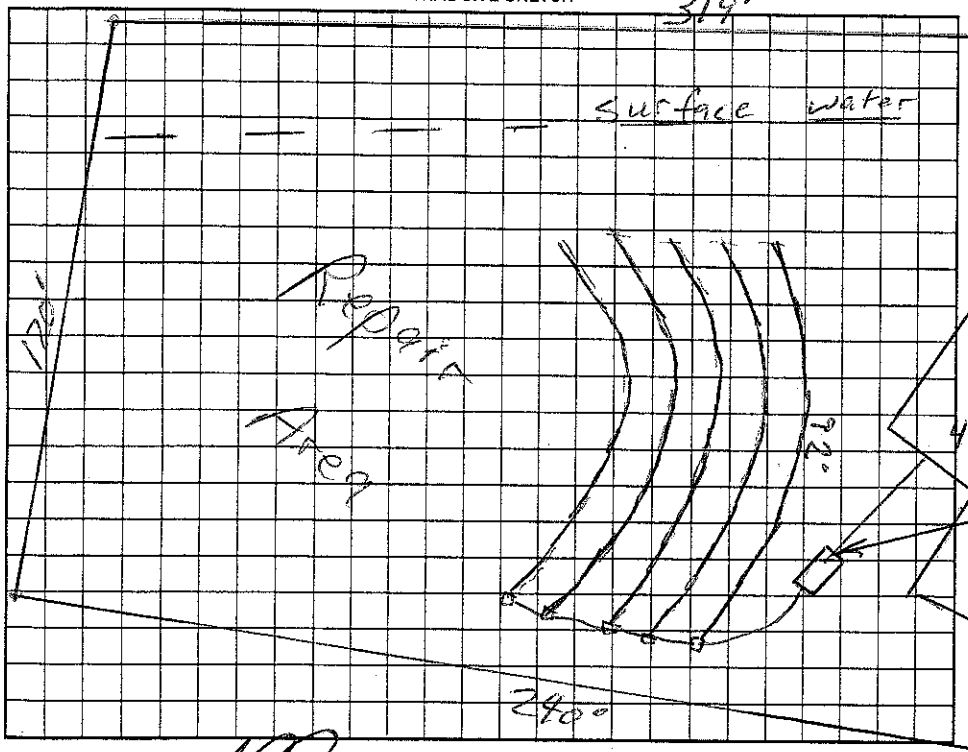

AS BUILT SKETCH

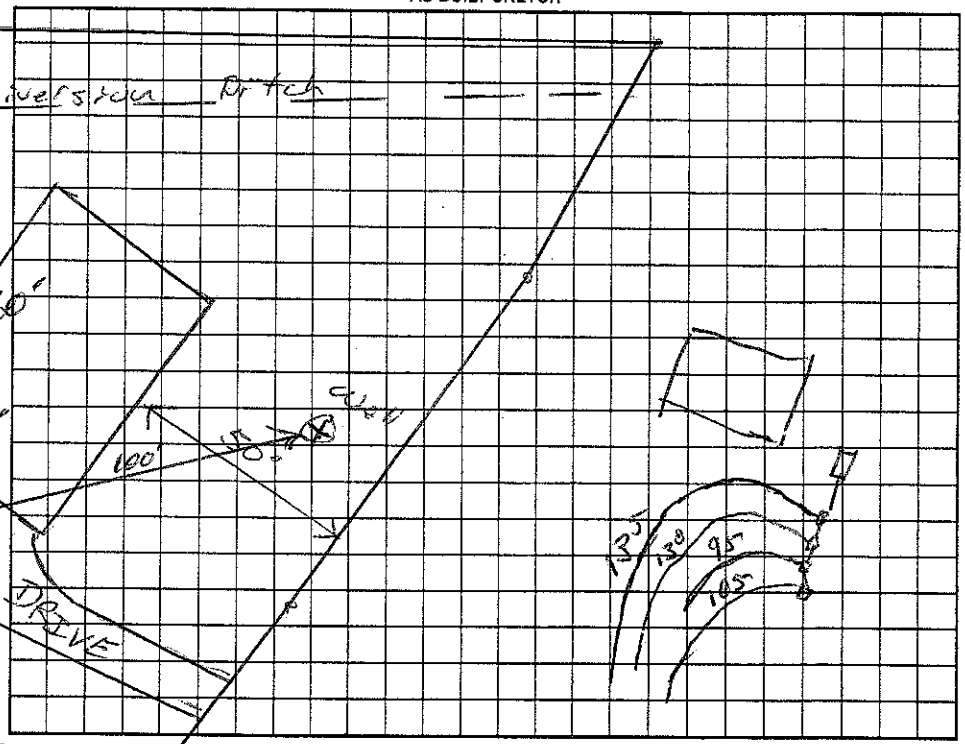

Permit can be suspended or revoked if any false information is supplied toward securing the permit/any unauthorized changes are made to the site/any unauthorized changes are made in the installation of the system. Improvement Permit with plat valid without expiration. Improvement Permit with site plan valid for sixty months. Authorization to Construct is valid for a period equal to that of Improvement Permit – not to exceed sixty months.

Signed: date 5-20-04 Installed by: A-1 Backhoe

Improvement Permit by: RS date 5/20/04 Operation Permit by: RS date 8/31/04

Authorization to Construct by: Wesley Sparks R.S. date 7/21/04 Existing System Inspection by: date

HEALTH DEPT. COPY: WHITE OWNER COPY (FINAL): YELLOW OWNER COPY (INITIAL): PINK