IREDELL COUNTY HEALTH DEPARTMENT

STATESVILLE 704-878-5305 MOORESVILLE 704-664-5281

IMPROVEMENT PERMIT / AUTHORIZATION TO CONSTRUCT / OPERATION PERMIT / EXISTING SYSTEM INSPECTION

PERMIT# 141763 PIN# ~~4658072544~~ 4658-07-6538 DATE 6-26-07

OWNER OR APPLICANT Sixto Ruiz PHONE: Business 704-507-5093 Home

ADDRESS 175 Carriage Club Dr Apt. 9-203 Mooresville NC 28117

LOCATION Hwy 21 N TL Cornelius TR Olympia on corner of Sparta

SUBDIVISION CORNELIUS ESTATES BLOCK / SECTION LOT ~~26~~ 1 LOT AREA .575 Ac. SITE CLASS. PS DESIGN FLOW 360gpd L.T.A.R. .3gpd/ft²

Septic Tank: 1000 Gallons; STB 1012 Date 3-19-07
Pump Tank: Gallons; PT Date
Pump Make: Model Serial No.
Nitrification Field: No Fields 1 Square Feet Linear Feet 300
No Lines 3@100' Trench Width 36" Max Trench Bottom Depth 36"

☒ New System ☐ Repair ☐ Expansion System Type: I ☒ II III IV V VI
System Description: 25% reduction gravity
Repair System Description: LP PPBPS
Maintenance Agreement Required: ☐ Yes ☒ No

☒ House/Mod. Home No. Bedrooms 3
☐ Mobile Home No. Persons 6
☐ Business No. Employees
☐ Other


Water Supply: ☒ Individual ☐ Public ☐ Community

Gravel Depth NA ☒ Gravity ☐ Pressure ☐ Slab ☒ Crawl Space ☐ Basement w/plumbing ☐ Basement wo/plumbing

Comments:/Conditions: 100' separation well to system
Remove any maple trees in system area
Hold AC until property recorded w/ Register of Deeds

Comments:/Conditions: 6/29/07 - Revised Hor. Plan for 360Rm
Crawl Space home - WS

INITIAL SITE SKETCH

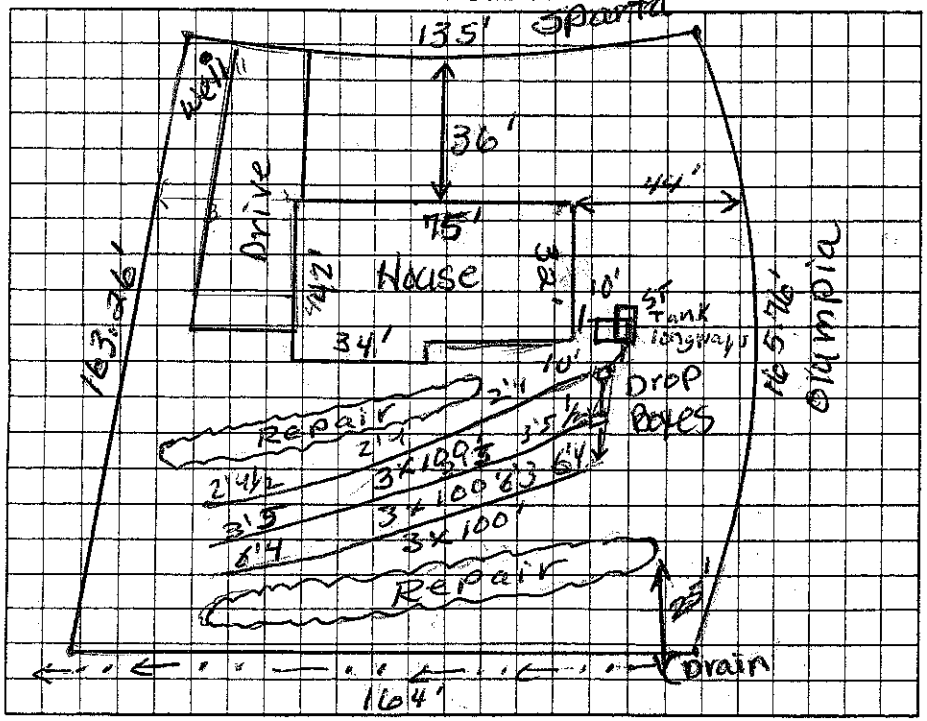

AS BUILT SKETCH

Infiltrator Q4 Installed
No well on site at time of inspection
Installed as designed
10/2/07 AC

Permit can be suspended or revoked if any false information is supplied toward securing the permit/any unauthorized changes are made to the site/any unauthorized changes are made in the installation of the system. Improvement Permit with plat valid without expiration ☐ Improvement Permit with site plan valid for sixty months ☒ Authorization to Construct is valid for a period equal to that of Improvement Permit – not to exceed sixty months.

Signed: [signature] date 6-29-07 Installed by: A-1 Backhoe

Improvement Permit by: Judy Melville date 6-26-07 Operation Permit by: Anthony Coker Jr date 10/2/07

Authorization to Construct by: [signature] RS date 6/29/07 Existing System Inspection by: date

HEALTH DEPT. COPY: WHITE OWNER COPY (FINAL): YELLOW OWNER COPY (INITIAL): PINK