Exis. System

IREDELL COUNTY HEALTH DEPARTMENT

STATESVILLE 704-878-5305 MOORESVILLE 704-664-5281

IMPROVEMENT PERMIT / AUTHORIZATION TO CONSTRUCT / OPERATION PERMIT / EXISTING SYSTEM INSPECTION

PERMIT# 146707 PIN# 4658073496.095 / 4658 07 6566 DATE 11/29/07

OWNER OR APPLICANT Robert Lhuillier Ray PHONE: Business Home

ADDRESS 120 Sparta Dr. Mooresville NC 28115

LOCATION 31 N TL Cornelius Rd TR on Olympic TL Sparta on Right 120 Sparta Dr.

SUBDIVISION Cornelius Est. BLOCK / SECTION LOT 95 LOT AREA .579 SITE CLASS PS DESIGN FLOW 360 L.T.A.R. .025

Septic Tank Exis 1000 Gallons: STB Date

Pump Tank Exis 1000 Gallons: PT Exis Date

Pump Make: Model Serial No.

Nitrification Field: No Fields 1 Square Feet 765 Linear Feet Ex. 255'

No Lines Ex 5 Trench Width Max Trench Bottom Depth 36" Gravel Depth

☐ New System ☐ Repair ☐ Expansion System Type: I II III (IV) V VI

System Description: Existing LP Panel

Repair System Description:

Maintenance Agreement Required: ☑ Yes ☐ No Exis

☑ House/Mod. Home ☐ Mobile Home ☐ Business ☐ Other

No. Bedrooms 3 No. Persons No. Employees

Water Supply: ☑ Individual ☐ Public ☐ Community


☐ Gravity ☐ Pressure ☐ Slab ☑ Crawl Space ☐ Basement w/plumbing ☐ Basement wo/plumbing

Comments:/Conditions:


Comments:/Conditions: System installed as shown, Detached 20'x20' garage maybe put on property as shown
Repair area verified 11/29/07 (See original Permit) Corinthian Builders 9/12/07
No visible malfunction of Exis system

1"=60'

INITIAL SITE SKETCH

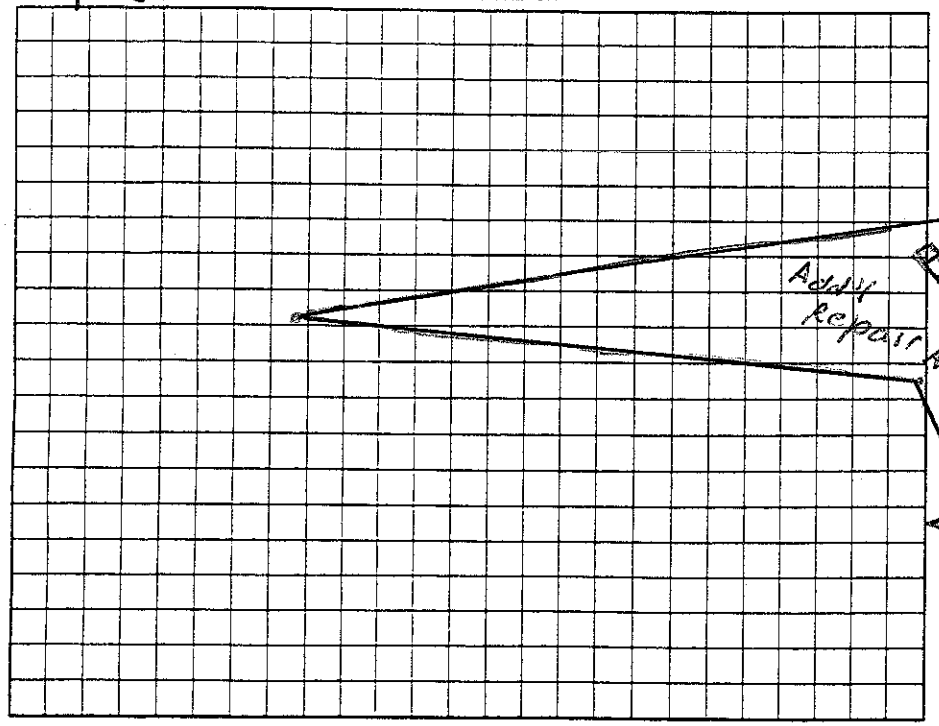

AS BUILT SKETCH

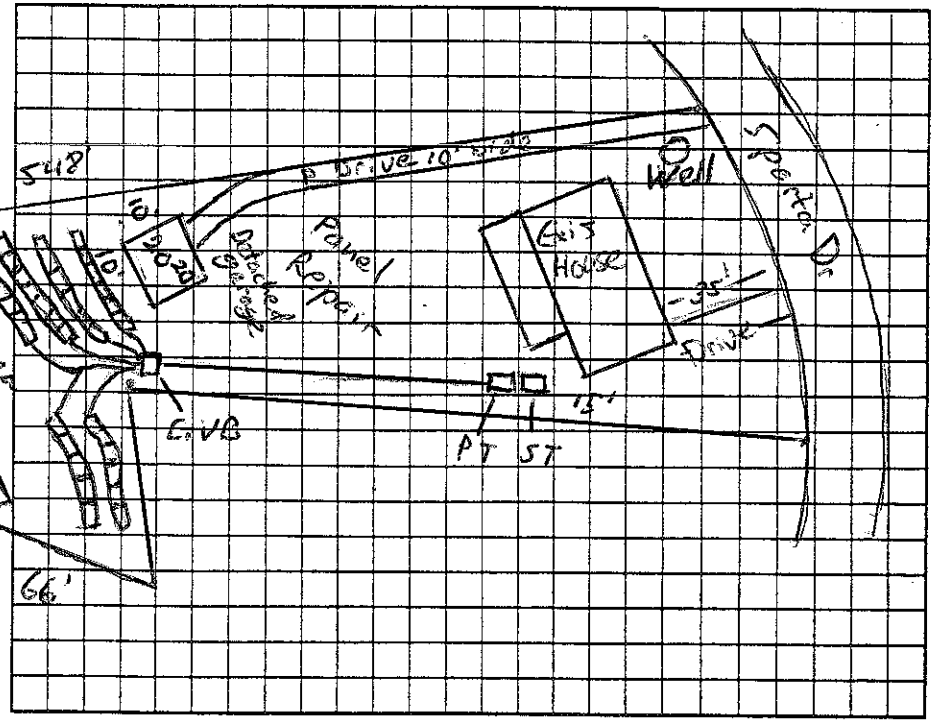

Permit can be suspended or revoked if any false information is supplied toward securing the permit/any unauthorized changes are made to the site/any unauthorized changes are made in the installation of the system. Improvement Permit with plat valid without expiration ☐ Improvement Permit with site plan valid for sixty months ☐ Authorization to Construct is valid for a period equal to that of Improvement Permit – not to exceed sixty months.

Signed: B. D. Ray date 11/26/07 Installed by:

Improvement Permit by: date Operation Permit by: date

Authorization to Construct by: date Existing System Inspection by: Anthony Coberly date 11/29/07

HEALTH DEPT. COPY: WHITE OWNER COPY (FINAL): YELLOW OWNER COPY (INITIAL): PINK