IREDELL COUNTY HEALTH DEPARTMENT

STATESVILLE 704-878-5305 / 130.00 Paid / MOORESVILLE 704-664-5281

IMPROVEMENT PERMIT / AUTHORIZATION TO CONSTRUCT / OPERATION PERMIT / EXISTING SYSTEM INSPECTION

PERMIT# 24623 PIN# 4658070774 DATE 12-1-04

OWNER OR CONTRACTOR Expression Homes PHONE: Business 902-7773 Home J.W 746-5407

ADDRESS 1042 Charlotte Highway Troutman, NC 28166

LOCATION Hwy 21 N TL Bailey Rd dead ends into Olympia lot on left

SUBDIVISION Cornelius Est BLOCK / SECTION LOT 57 LOT AREA .67 Acre SITE CLASS PS DESIGN FLOW 360gpd L.T.A.R. .3

Septic Tank: 1000 Gallons; STB 1012 Date 6/25/04
Pump Tank: 1000 Gallons; PT 17 Date 9/15/04
Pump Make: Goulds Model WE0311M Serial No.
Nitrification Field: No Fields 1 Square Feet 400' Linear Feet 200'
No Lines 4@50' Trench Width 24" Max Trench Bottom Depth 30" Gravel Depth N/A

[X] New System [ ] Repair System Type: I, II, (III), IV, V, VI
System Description: Pump (PM) Panel Block
Repair System Description: Same
Maintenance Agreement Required: [ ] Yes [X] No


[X] House/Mod. Home No. Bedrooms 3
[ ] Mobile Home No. Bathrooms 2
[ ] Business No. Employees
[ ] Other
[ ] Slab [X] Crawl Space [ ] Basement w/plumbing [ ] Basement wo/plumbing

Water Supply: [X] Individual [ ] Public [ ] Community


Comments/Conditions: Keep Septic Tank & lines 100' to well
Keep Septic System at least 10' to PL
Keep House 100' off back PL (back right corner)

Comments/Conditions: 12/17/04 Rotating house
Tanks & lines checked by GM 12/16/04
Pres. & elect checked 1/27/05 mp
Alarm checked 3/31/05 mp

INITIAL SITE SKETCH Scale 1:50

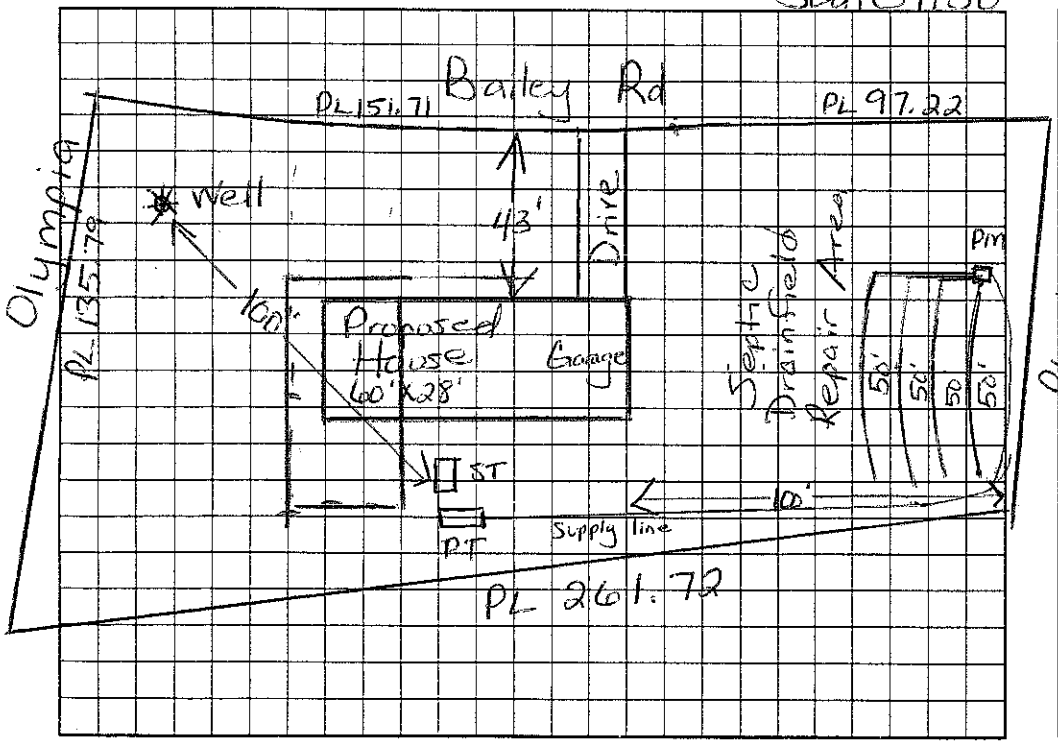

AS BUILT SKETCH

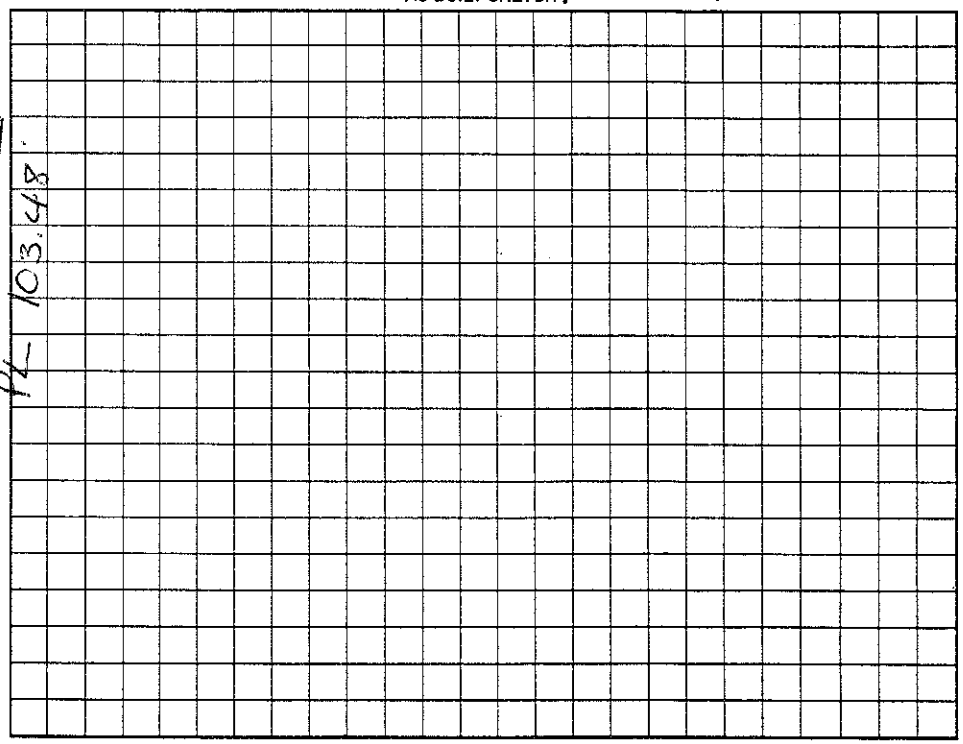

Permit can be suspended or revoked if any false information is supplied toward securing the permit/any unauthorized changes are made to the site/any unauthorized changes are made in the installation of the system. Improvement Permit with plat valid without expiration. Improvement Permit with site plan valid for sixty months. Authorization to Construct is valid for a period equal to that of Improvement Permit – not to exceed sixty months.

Signed: Dennis Dallek date 12-2-04 Installed by: A-1 Backhoe

Improvement Permit by: Myra H H Dotson RS date 12/1/04 Operation Permit by: Myra H H Dotson date 3/31/05

Authorization to Construct by: Myra H H Dotson RS date 12/1/04 Existing System Inspection by: date

HEALTH DEPT. COPY: WHITE OWNER COPY (FINAL): YELLOW OWNER COPY (INITIAL): PINK