IREDELL COUNTY HEALTH DEPARTMENT

STATESVILLE 704-878-5305 MOORESVILLE 704-664-5281

IMPROVEMENT PERMIT / AUTHORIZATION TO CONSTRUCT / OPERATION PERMIT / EXISTING SYSTEM INSPECTION

PERMIT# 136215 PIN# 4658 07 8158 DATE 6/22/06

OWNER OR APPLICANT Corinthian Builders LTD PHONE: Business 704-406-1258 Home

ADDRESS PO Box 990 Duncan, NC. 28037

LOCATION 21 N to Bailey Rd on R at intersection with Olympia Drive

SUBDIVISION Cornelius Estates BLOCK / SECTION LOT 70 LOT AREA ~.8Ac SITE CLASS. PS DESIGN FLOW 360 L.T.A.R. .3

Septic Tank: 1000 v Gallons; STB 786 Date 4/13/06

Pump Tank: 1000 Gallons; PT 32 Date 5/29/06

Pump Make: LittleGiant Model 4-CPCIM Serial No.

Nitrification Field: No Fields 1 Square Feet 1050 Linear Feet 350

No Lines 5@70 Trench Width 3 Max Trench Bottom Depth 3

☒ New System ☐ Repair ☐ Expansion System Type: I II (III) IV V VI

System Description: PM - 2507, Reduced

Repair System Description: Same Type

Maintenance Agreement Required: ☐ Yes ☒ No

☒ House/Mod. Home ☐ Mobile Home ☐ Business ☐ Other

No. Bedrooms 3 No. Persons 3 No. Employees

Water Supply: ☒ Individual ☐ Public ☐ Community

Gravel Depth No ☐ Gravity ☐ Pressure ☐ Slab ☒ Crawl Space ☐ Basement w/plumbing ☐ Basement wo/plumbing

Comments:/Conditions: Site Plan & Layout prepared by S+EC. 2507 Reduced Syst w/ Pressure Manifold

Comments:/Conditions: Infiltrator installed

INITIAL SITE SKETCH

See Attached Layout Plan

AS BUILT SKETCH

Permit can be suspended or revoked if any false information is supplied toward securing the permit/any unauthorized changes are made to the site/any unauthorized changes are made in the installation of the system. Improvement Permit with plat valid without expiration. ☐ Improvement Permit with site plan valid for sixty months ☐ Authorization to Construct is valid for a period equal to that of Improvement Permit – not to exceed sixty months.

Signed: Melissa Neal date 6-23-06 Installed by: Corinthian Dev. - Cothern


Improvement Permit by: Wesley Sparks RS. date 6/22/06 Operation Permit by: Wesley Sparks RS. date 11/8/06

Authorization to Construct by: Wesley Sparks RS. date 6/22/06 Existing System Inspection by: date

HEALTH DEPT. COPY: WHITE OWNER COPY (FINAL): YELLOW OWNER COPY (INITIAL): PINK

Repair Dashed
LOT 70

NOT A SURVEY

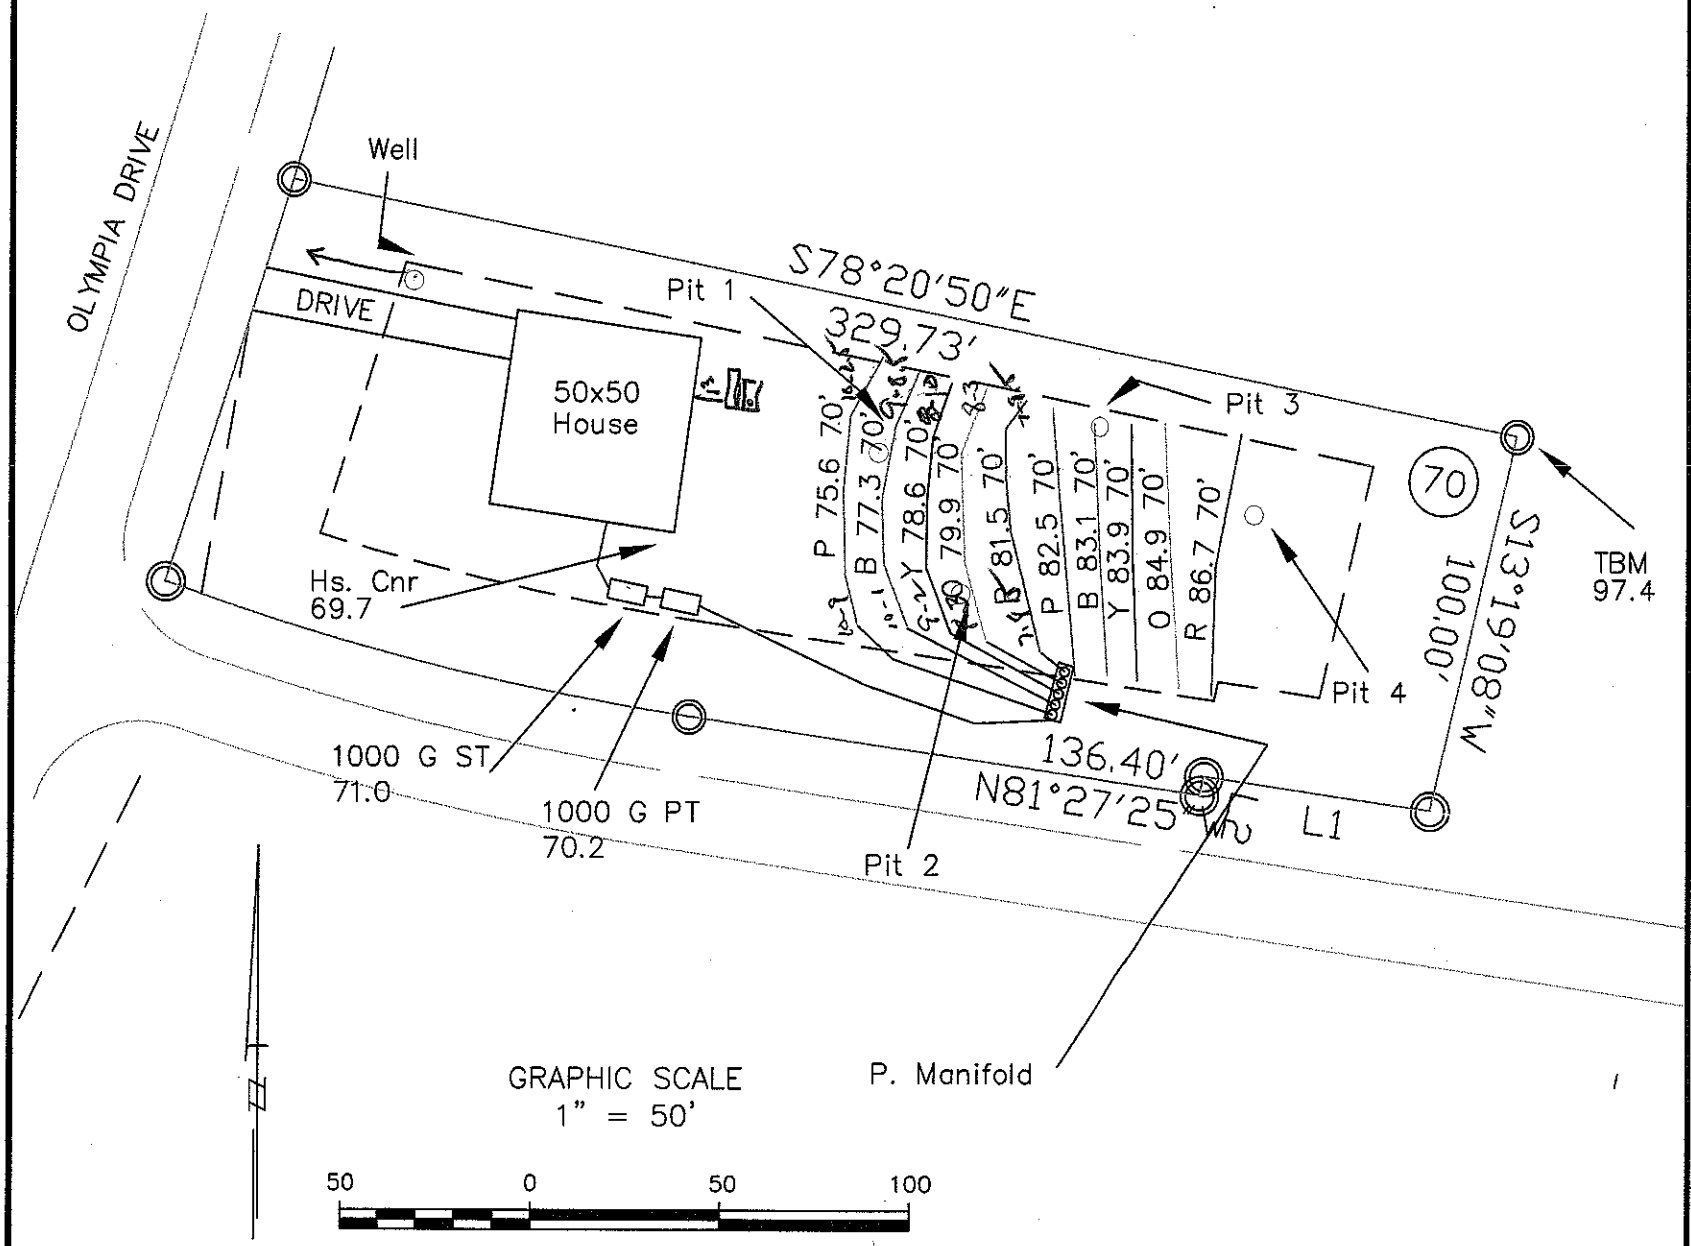

PROJECT NO.
S-1781
PROJECT MGR.
WO
DRAWN BY
BF
FIELD WORK
EB,BF,WO
SCALE
1" = 50'
FILE
C:\JOBS\S-1781

Soil & Environmental Consultants, PA
226 Lafayette Ct. STE C • Concord, North Carolina 28025 • Phone (704)786-1495 • Fax (704) 786-1496

PROJECT NAME: OLYMPIA DRIVE
CORINTHIAN BUILDERS
- OLYMPIA DRIVE -
IREDELL COUNTY, NORTH CAROLINA
JUNE 2005

SHEET TITLE:
FAST TRACK
SKETCH MAP

SHEET
1 OF 1