IREDELL COUNTY HEALTH DEPARTMENT

STATESVILLE 704-878-5305 MOORESVILLE 704-664-5281

IMPROVEMENT PERMIT / AUTHORIZATION TO CONSTRUCT / OPERATION PERMIT / EXISTING SYSTEM INSPECTION

PERMIT# 136216 PIN# 4658 07 9340 DATE 6/22/06

OWNER OR APPLICANT Corinthian Builders Ltd. PHONE: Business 704-400-1258 Home

ADDRESS PO Box 990 Denver, NC 28037

LOCATION 21N TL Barkley Rd. TR Olympia Dr. 2ND lot on (R)

SUBDIVISION Connlin Estates BLOCK / SECTION LOT 71 LOT AREA ~1 ac SITE CLASS. PS DESIGN FLOW 360 L.T.A.R. .3

Septic Tank: 1000 Gallons; STB 136 Date 4/10/06
Pump Tank: 1000 Gallons; PT 32 Date 5/8/06
Pump Make: LittleGiant Model 14-EH Serial No.
Nitrification Field: No Fields 1 Square Feet 900 Linear Feet 300
No Lines 3@100 Trench Width 3 Max Trench Bottom Depth 3'

☒ New System ☐ Repair ☐ Expansion System Type: I II III IV V VI
System Description: PM → 25% Reduced
Repair System Description: Same Type
Maintenance Agreement Required: ☐ Yes ☒ No

☒ House/Mod. Home ☐ Mobile Home ☐ Business ☐ Other
No. Bedrooms 3 No. Persons 3 No. Employees

Water Supply: ☐ Individual ☐ Public ☐ Community

Gravel Depth No ☐ Gravity ☒ Pressure ☐ Slab ☐ Crawl Space ☐ Basement w/plumbing ☐ Basement wo/plumbing

Comments:/Conditions:
Fast Track - Field work & Site Plan done by S+EC.

Comments:/Conditions:
Infiltrator installed

INITIAL SITE SKETCH

See Attached Site Plan

Sheet 1 of 1 S+EC Plan

AS BUILT SKETCH

Permit can be suspended or revoked if any false information is supplied toward securing the permit/any unauthorized changes are made to the site/any unauthorized changes are made in the installation of the system. Improvement Permit with plat valid without expiration ☐ Improvement Permit with site plan valid for sixty months ☑ Authorization to Construct is valid for a period equal to that of Improvement Permit – not to exceed sixty months.

Signed: Melissa Lea date 6/23/06

Improvement Permit by: Wesley Sparks RS date 6/22/06


Authorization to Construct by: Wesley Sparks RS date 6/22/06

Installed by: Corinthian / Letters

Operation Permit by: Wesley Sparks RS date 11/8/06

Existing System Inspection by: date

HEALTH DEPT. COPY: WHITE OWNER COPY (FINAL): YELLOW OWNER COPY (INITIAL): PINK

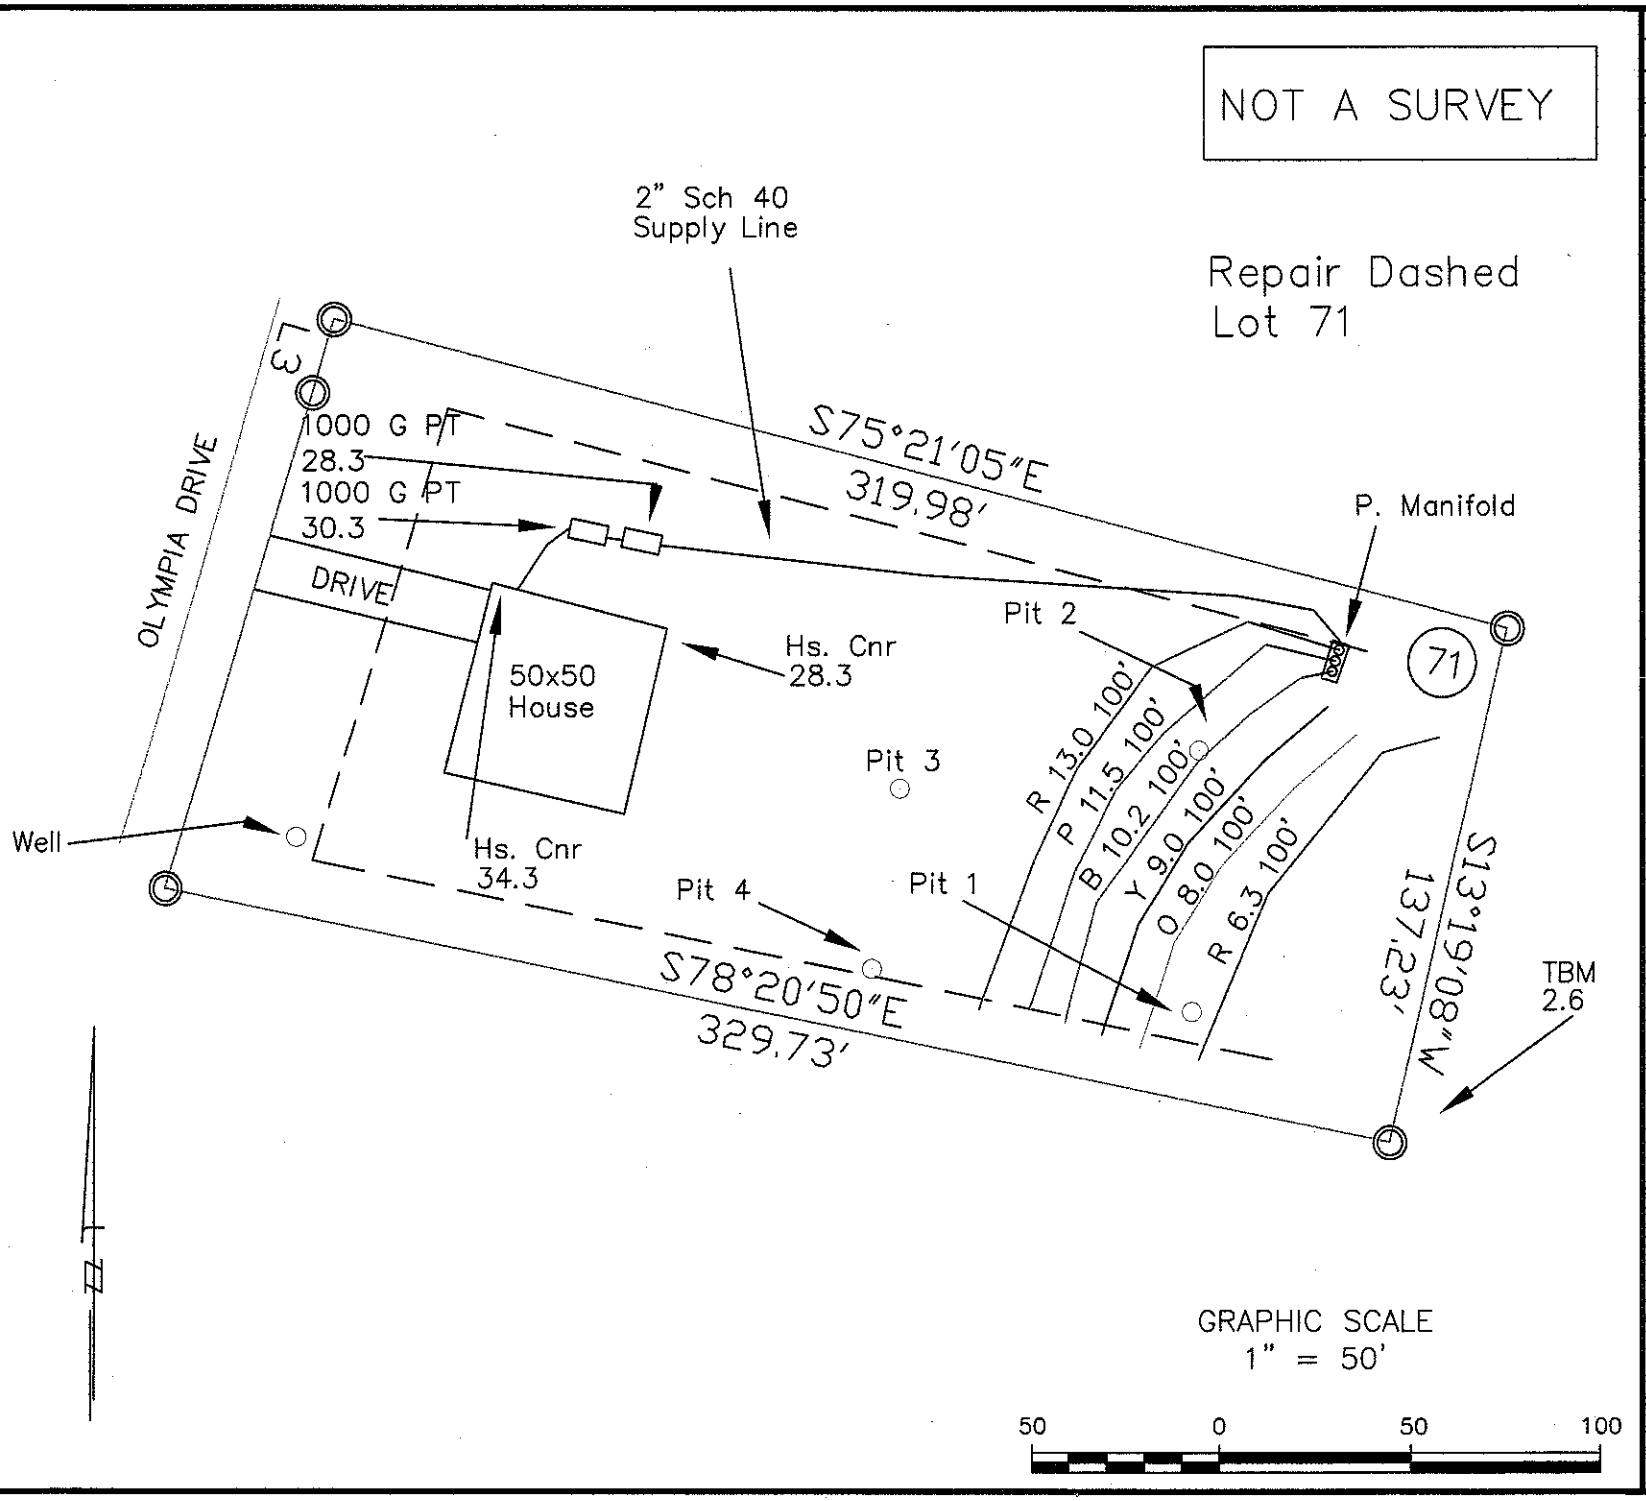

PROJECT NO. 5-1781
PROJECT MGR. WO
DRAWN BY BF
FIELD WORK EB,BF,WO
SCALE 1" = 50'
FILE C:\JOBS\5-1781

Soil & Environmental Consultants, PA
836 Lafayette Ct. STE C ■ Concord, North Carolina, 28025 ■ Phone (704)720-9403 ■ Fax (704) 720-9406

S&EC

PROJECT NAME: OLYMPIA DRIVE
CORNITHIAN HOMEBUILDERS
- OLYMPIA DRIVE -
IREDELL COUNTY, NORTH CAROLINA
JUNE 2006

SHEET TITLE:
PAST TRACK SKETCH MAP

SHEET
1 OF 1