IREDELL COUNTY HEALTH DEPARTMENT

STATESVILLE 704-878-5305 50.00 Paid MOORESVILLE 704-664-5281

IMPROVEMENT PERMIT / AUTHORIZATION TO CONSTRUCT / OPERATION PERMIT / EXISTING SYSTEM INSPECTION

PERMIT# 118288 PIN# ~~4658083674~~ 4658083593.000 DATE 1/18/05

OWNER OR CONTRACTOR CORINTHIAN DEV. PHONE: Business 597-9647 Home

ADDRESS PO BOX 490 DENVER NC 28037

LOCATION 2 N TL CORNELIUS - TR OLYMPIA DR. - TL SPARTA - ON RT NEAR END

SUBDIVISION CORNELIUS EST. BLOCK / SECTION LOT 80 LOT AREA .868A. SITE CLASS. PS DESIGN FLOW 360.00 L.T.A.R. .25/0.125

Septic Tank: 1000 Gallons; STB 786 Date 12/3/04

Pump Tank: 1000 Gallons; PT 32 Date

Pump Make: Model Serial No.

Nitrification Field: No Fields 1 Square Feet 520 Linear Feet 250

No Lines 5@50' Trench Width 24" Max Trench Bottom Depth 30" Gravel Depth N/A

☑ New System ☐ Repair System Type: I, II, III, IV, V, VI

System Description: PUMP PANEL

Repair System Description: & LP PANEL

Maintenance Agreement Required: ☐ Yes ☑ No

☑ House/Mod. Home No. Bedrooms 3

☐ Mobile Home No. Bathrooms 3

☐ Business No. Employees

☐ Other


☐ Slab ☑ Crawl Space ☐ Basement w/plumbing ☐ Basement wo/plumbing

Water Supply: ☑ Individual ☐ Public ☐ Community


Comments:/Conditions:

Comments:/Conditions:

INITIAL SITE SKETCH 1" = 50'

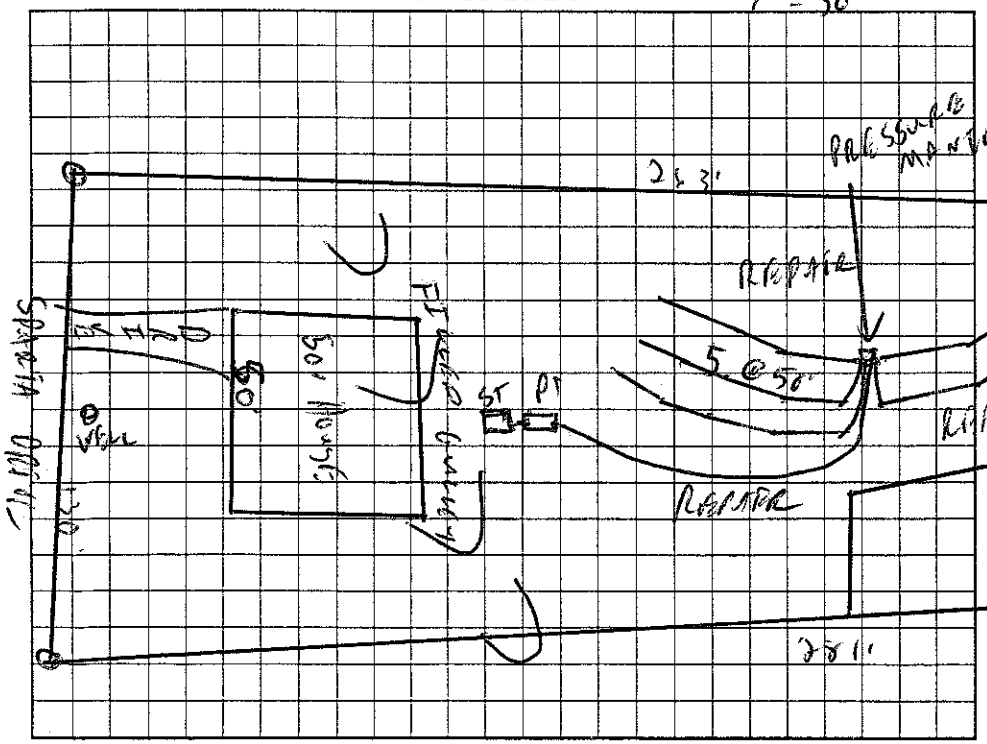

AS BUILT SKETCH

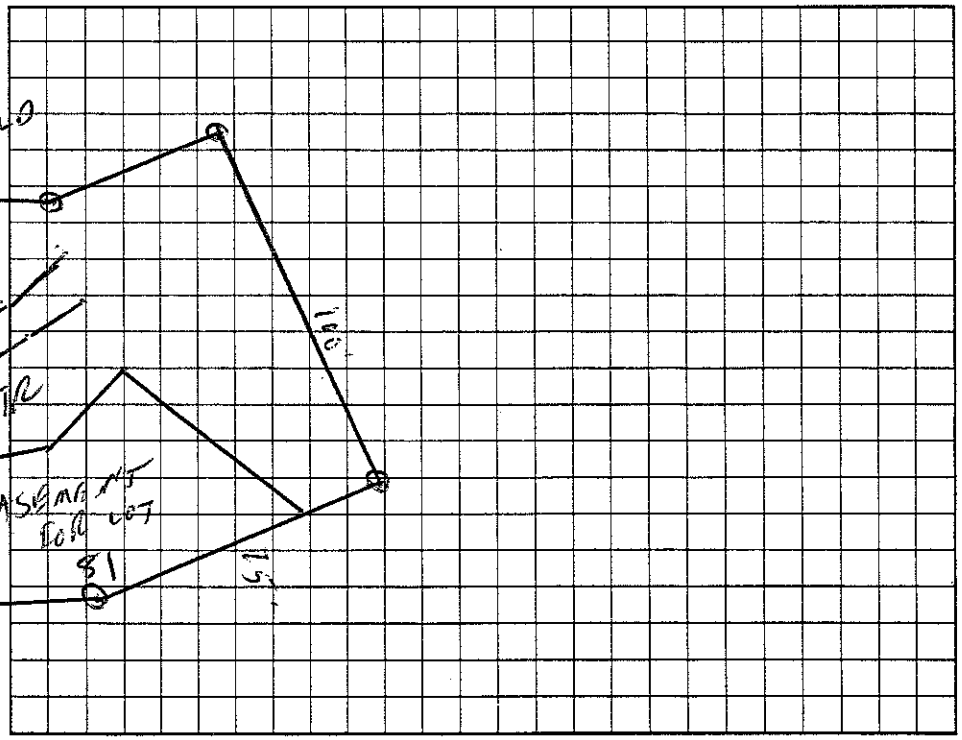

Permit can be suspended or revoked if any false information is supplied toward securing the permit/any unauthorized changes are made to the site/any unauthorized changes are made in the installation of the system. Improvement Permit with plat valid without expiration. Improvement Permit with site plan valid for sixty months. Authorization to Construct is valid for a period equal to that of Improvement Permit – not to exceed sixty months.

Signed: date 1-18-05 Installed by: Corinthian Bldrs

Improvement Permit by: RS date 1/18/05 Operation Permit by: RS date 5/4/05

Authorization to Construct by: RS date 1/18/05 Existing System Inspection by: date

HEALTH DEPT. COPY: WHITE OWNER COPY (FINAL): YELLOW OWNER COPY (INITIAL): PINK