IREDELL COUNTY HEALTH DEPARTMENT

STATESVILLE 704-878-5305 MOORESVILLE 704-664-5281

IMPROVEMENT PERMIT / AUTHORIZATION TO CONSTRUCT / OPERATION PERMIT / EXISTING SYSTEM INSPECTION

PERMIT# 18287 PIN# 4658 08 3677.067 3684 DATE 4/27/04

OWNER OR CONTRACTOR CORINTHIAN DEVELOPERS PHONE: Business 827-9697 Home

ADDRESS PO BOX 990 DENVER NC 28037

LOCATION 21N - TL CORNELIUS RD - TR OLYMPIA - TL SPARTA - ON RT NEAR END

SUBDIVISION CORNELIUS ESTATES BLOCK / SECTION LOT 79 LOT AREA 1.658AC SITE CLASS. PS DESIGN FLOW 360GPD L.T.A.R. .25GPD/FT²

Septic Tank: 1000 Gallons; STB TBK Date 2/1/04

Pump Tank: Gallons; PT Date

Pump Make: Model Serial No.

Nitrification Field: No Fields 1 Square Feet 1080 Linear Feet 360

No Lines 3 @ 120' Trench Width 36" Max Trench Bottom Depth 30" Gravel Depth N/A

☑ New System ☐ Repair System Type: I, II, III, IV, V, VI

System Description: GRAVITY 25% REDUCTION

Repair System Description: LP LINE L

Maintenance Agreement Required: ☐ Yes ☑ No

☑ House/Mod. Home No. Bedrooms 3

☐ Mobile Home No. Bathrooms 3

☐ Business No. Employees

☐ Other


☐ Slab ☑ Crawl Space ☐ Basement w/plumbing ☐ Basement wo/plumbing

Water Supply: ☑ Individual ☐ Public ☐ Community


Comments:/Conditions: DO NOT CUT HOUSE PAD

Comments:/Conditions:

INITIAL SITE SKETCH 1" = 50'

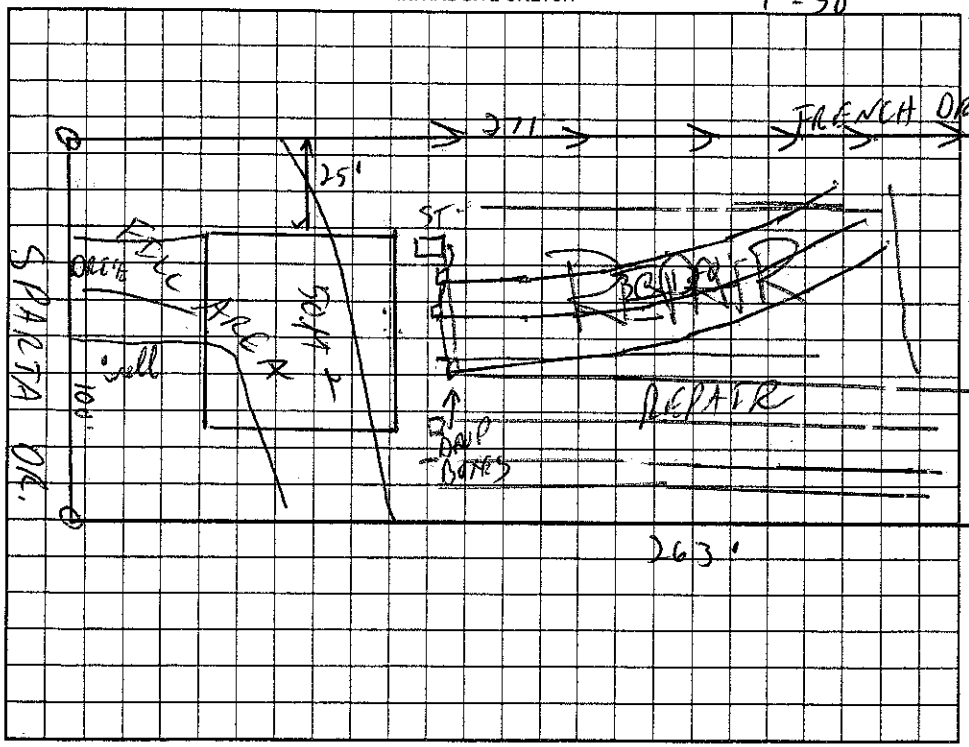

AS BUILT SKETCH

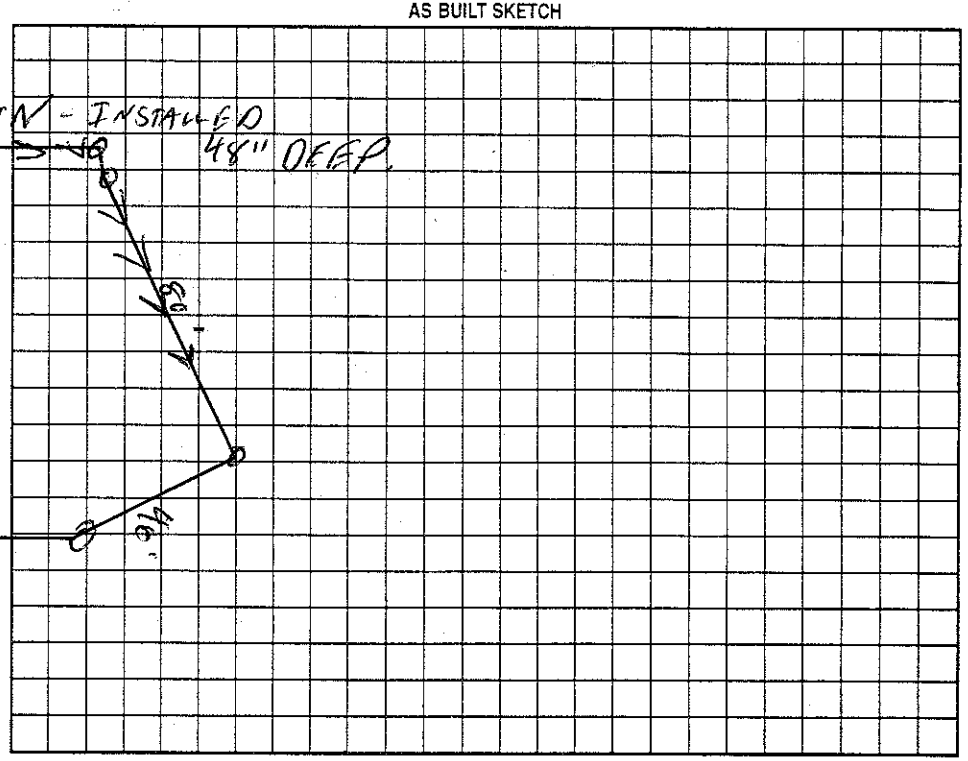

Permit can be suspended or revoked if any false information is supplied toward securing the permit/any unauthorized changes are made to the site/any unauthorized changes are made in the installation of the system. Improvement Permit with plat valid without expiration. Improvement Permit with site plan valid for sixty months. Authorization to Construct is valid for a period equal to that of Improvement Permit – not to exceed sixty months.

Signed: date 4-28-04 Installed by: Corinthian Bldrs

Improvement Permit by: C. Mays RS date 4/27/04 Operation Permit by: Wade Sparks RS. date 10/26/04

Authorization to Construct by: C. Mays RS date 4/28/04 Existing System Inspection by: date

HEALTH DEPT. COPY: WHITE OWNER COPY (FINAL): YELLOW OWNER COPY (INITIAL): PINK