IREDELL COUNTY HEALTH DEPARTMENT

STATESVILLE 704-878-5305 130.00 Paid MOORESVILLE 704-[illegible]

IMPROVEMENT PERMIT / AUTHORIZATION TO CONSTRUCT / OPERATION PERMIT / EXISTING SYSTEM INSPECTION

PERMIT# 118382 PIN# 4658 08 36 74.064 4658-08-3985 DATE 8/4/04

OWNER OR CONTRACTOR CORINTHIAN DEVELOPERS LTD PHONE: Business 827-9697 Home

ADDRESS PO BOX 990 DENVER NC 28037

LOCATION 21(N) - TL CORNELIUS RD - TR OLYMPIA - TL SPARTA - ON RT

SUBDIVISION CORNELIUS ESTATES BLOCK / SECTION LOT 76 LOT AREA 1.57 SITE CLASS. PS DESIGN FLOW 360GPD L.T.A.R. .30 APPLIED

Septic Tank: 1000 Gallons: STB 1186 Date 5/11/04

Pump Tank: 1000 Gallons: PT 32 Date 5/11/04

Pump Make: Goulds Model PE51 Serial No. D235001S

Nitrification Field: No Fields 1 Square Feet 420 Linear Feet 210

No Lines 6@35' Trench Width 24" Max Trench Bottom Depth 36" Gravel Depth N/A

☑ New System ☐ Repair System Type: I, II, (III), IV, V, VI

System Description: PUMP PANEL

Repair System Description: SAME LP

Maintenance Agreement Required: ☐ Yes ☑ No

☐ House/Mod. Home No. Bedrooms 3

☐ Mobile Home No. Bathrooms 3

☐ Business No. Employees

☐ Other


☐ Slab ☑ Crawl Space ☐ Basement w/plumbing ☐ Basement wo/plumbing

Water Supply: ☑ Individual ☐ Public ☐ Community

Comments:/Conditions: *DO NOT CUT HOUSE PAD* *BUILD UP ONLY*

Comments:/Conditions:

INITIAL SITE SKETCH 1"=60'

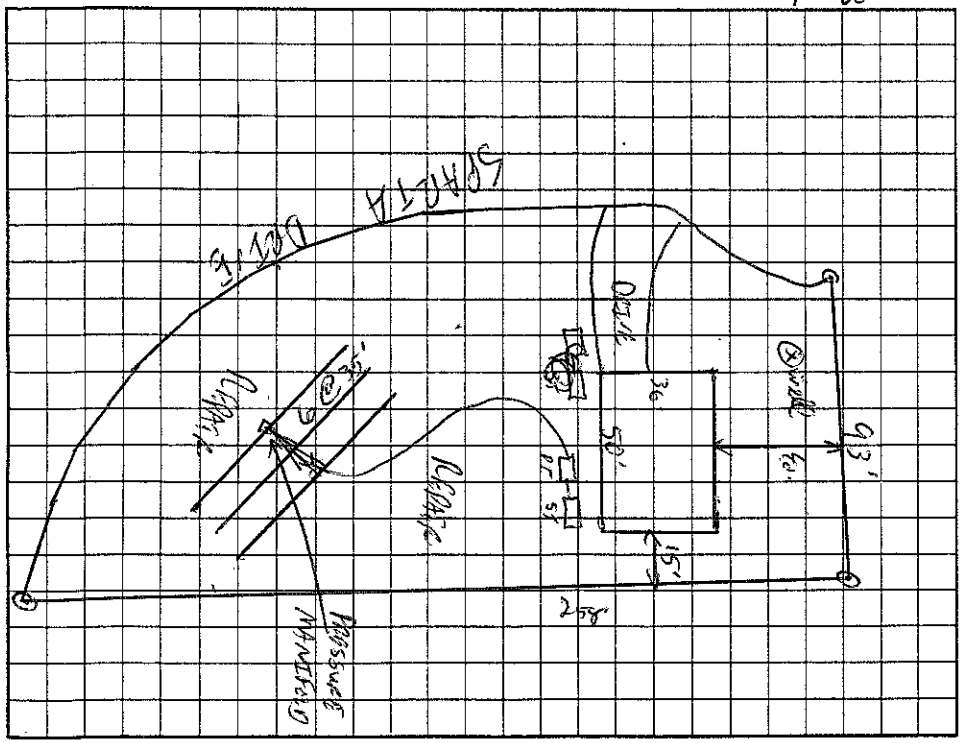

AS BUILT SKETCH

Permit can be suspended or revoked if any false information is supplied toward securing the permit/any unauthorized changes are made to the site/any unauthorized changes are made in the installation of the system. Improvement Permit with plat valid without expiration. Improvement Permit with site plan valid for sixty months. Authorization to Construct is valid for a period equal to that of Improvement Permit – not to exceed sixty months.

Signed: [signature] date 8-4-04

Improvement Permit by: [signature] RS date 8/4/04

Authorization to Construct by: [signature] RS date 8/4/04

Installed by: Corinthian Bldrs

Operation Permit by: [signature] RS date 12/1/04

Existing System Inspection by: date

HEALTH DEPT. COPY: WHITE OWNER COPY (FINAL): YELLOW OWNER COPY (INITIAL): PINK