IREDELL COUNTY HEALTH DEPARTMENT

STATESVILLE 704-878-5305 MOORESVILLE 704-364-5281

IMPROVEMENT PERMIT / AUTHORIZATION TO CONSTRUCT / OPERATION PERMIT / EXISTING SYSTEM INSPECTION

PERMIT# 118280 PIN# 4658 05 3674. 4658-08-4410 DATE 11/24/04

OWNER OR CONTRACTOR CORINTHIAN DEVELOPERS LTD PHONE: Business 827-4697 Home

ADDRESS PO Box 990 DENVER NC 28037

LOCATION CORNELIUS ESTATES - TR CORNELIUS ESTATES - TL SPARTA - ON RT

SUBDIVISION CORNELIUS ESTATES BLOCK / SECTION LOT 81 LOT AREA 1.572ac. SITE CLASS. PS DESIGN FLOW 360 GPD L.T.A.R. .256 ac/ac

Septic Tank: 1000 Gallons; STB 156 Date 9-1-04

Pump Tank: 1000 Gallons; PT 40 Date 9-11-04

Pump Make: Goulds Model WE07121H Serial No.

Nitrification Field: No Fields 1 Square Feet 480 Linear Feet 240

No Lines 8@30' Trench Width 24" Max Trench Bottom Depth 30" Gravel Depth 1/4

☑ New System ☐ Repair System Type: I, II, III, IV, V, VI

System Description: Pump Panel

Repair System Description: LOP OFFSITE

Maintenance Agreement Required: ☐ Yes ☑ No

☑ House/Mod. Home No. Bedrooms 3

☐ Mobile Home No. Bathrooms 3

☐ Business No. Employees

☐ Other

☐ Slab ☐ Crawl Space ☑ Basement w/plumbing ☐ Basement wo/plumbing

Water Supply: ☑ Individual ☐ Public ☐ Community


Comments:/Conditions:

PRESSURE MANIFOLD


Comments:/Conditions:

SEE PLAT FOR OFFSITE EASEMENT

INITIAL SITE SKETCH 1"=60'

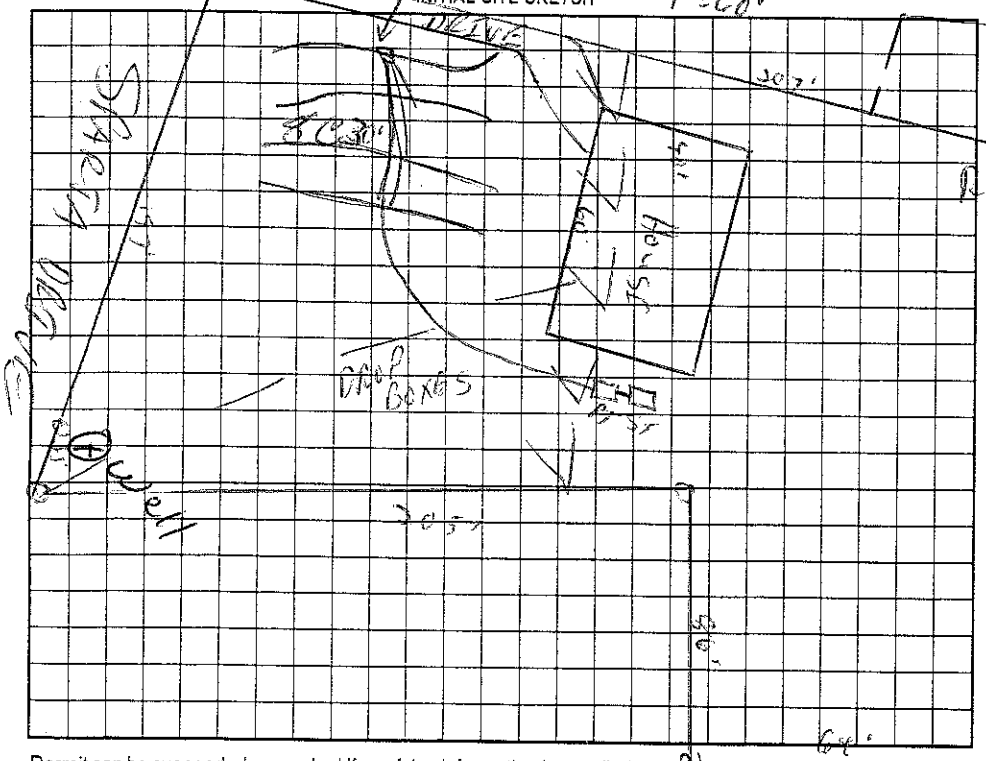

AS BUILT SKETCH

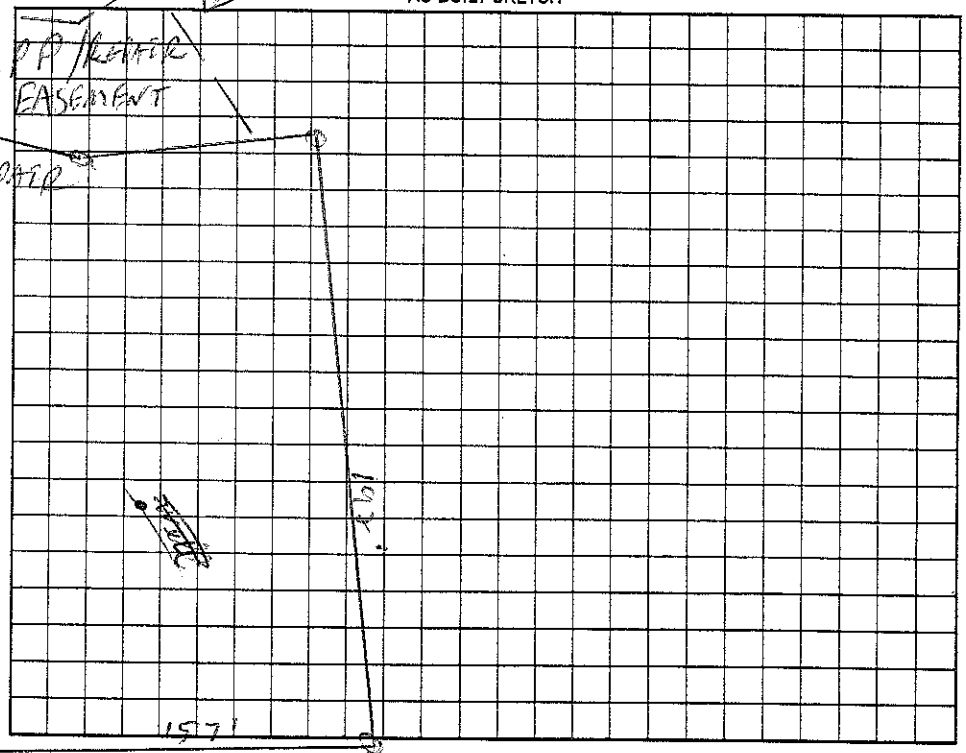

Permit can be suspended or revoked if any false information is supplied toward securing the permit/any unauthorized changes are made to the site/any unauthorized changes are made in the installation of the system. Improvement Permit with plat valid without expiration. Improvement Permit with site plan valid for sixty months. Authorization to Construct is valid for a period equal to that of Improvement Permit – not to exceed sixty months.

Signed: date 11/24/04 Installed by: Corinthian Bldrs.

Improvement Permit by: RS date 11/24/04 Operation Permit by: RS date 12/17/09

Authorization to Construct by: RS date 11/24/04 Existing System Inspection by: date

HEALTH DEPT. COPY: WHITE OWNER COPY (FINAL): YELLOW OWNER COPY (INITIAL): PINK