IREDELL COUNTY HEALTH DEPARTMENT

STATESVILLE 704-878-5305 130.00 Paid MOORESVILLE 704-664-5281

IMPROVEMENT PERMIT / AUTHORIZATION TO CONSTRUCT / OPERATION PERMIT / EXISTING SYSTEM INSPECTION

PERMIT# 118234 PIN# 4658 09 2214 DATE 2/25/04

OWNER OR CONTRACTOR Hans Builders (Steve Lawrence) PHONE: Business 704-663-2251 Home

ADDRESS 288 Robinson Rd. Mooresville, NC. 28117

LOCATION Cornelius Rd. TR Cornelius Estates, straight to T intersection TL, last lot on (L) before Cul de sac

SUBDIVISION Cornelius Estates BLOCK / SECTION LOT 29 LOT AREA 4.8 Ac SITE CLASS. PS DESIGN FLOW ~~600~~ 480 L.T.A.R. .3

Septic Tank: 1500 Gallons; STP 338 Date 9/27/05 ☒ New System ☐ Repair System Type: I, II, (III), IV, V, VI

Pump Tank: Gallons; PT Date System Description: Dist Box - 25% Reduced

Pump Make: Model Serial No. Repair System Description: Same Type

Nitrification Field: No Fields 1 Square Feet 1500 Linear Feet 500 Maintenance Agreement Required: ☐ Yes ☐ No

No Lines 5 @ 100' Trench Width 3' Max Trench Bottom Depth 3' Gravel Depth No

☒ House/Mod. Home No. Bedrooms 6

☐ Mobile Home No. Bathrooms 3.5

☐ Business No. Employees

☐ Other

☐ Slab ☐ Crawl Space ☒ Basement w/plumbing ☐ Basement wo/plumbing


Water Supply: ☒ Individual ☐ Public ☐ Community

Comments:/Conditions:

Comments:/Conditions:

1" = 100'

INITIAL SITE SKETCH

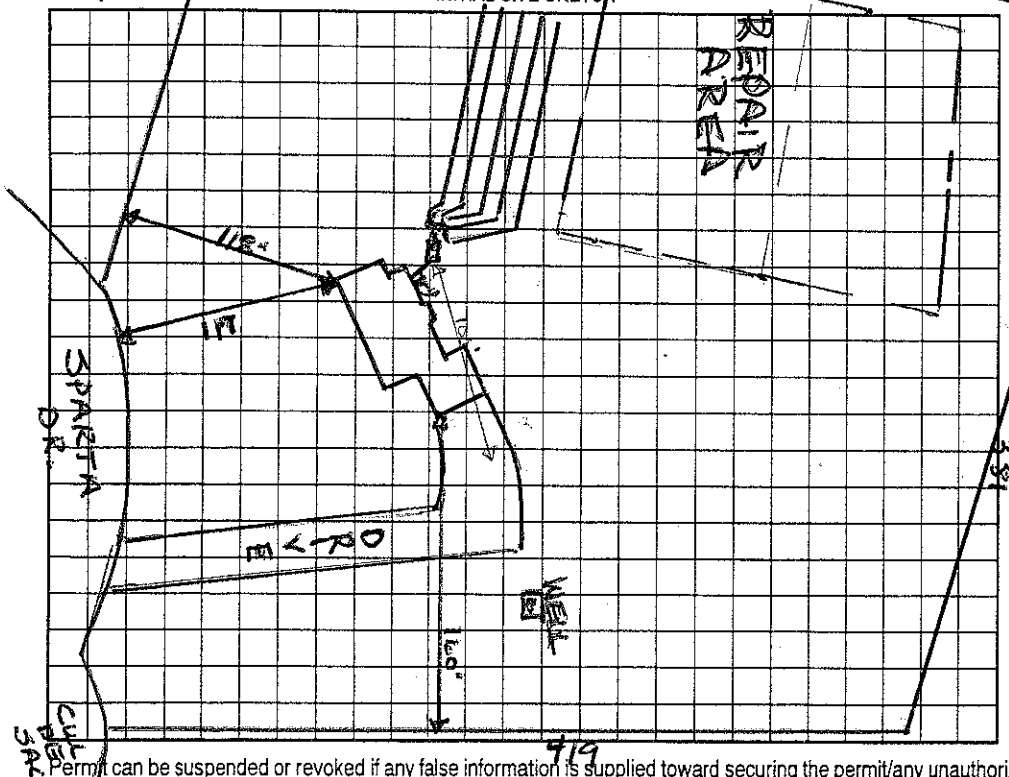

AS BUILT SKETCH

Infiltrator Quick 4 Installed

Permit can be suspended or revoked if any false information is supplied toward securing the permit/any unauthorized changes are made to the site/any unauthorized changes are made in the installation of the system. Improvement Permit with plat valid without expiration. Improvement Permit with site plan valid for sixty months. Authorization to Construct is valid for a period equal to that of Improvement Permit – not to exceed sixty months.

Signed: X date 2-25-04 Installed by: Larry Boggs

Improvement Permit by: Wesley Sparks RS. date 2/25/04 Operation Permit by: RS date 11/3/05

Authorization to Construct by: Wesley Sparks RS. date 2/25/04 Existing System Inspection by: date

HEALTH DEPT. COPY: WHITE OWNER COPY (FINAL): YELLOW OWNER COPY (INITIAL): PINK