4658101695 (3:00)

IREDELL COUNTY HEALTH DEPARTMENT Const. Auth. - STATESVILLE 704-878-5305 MOORESVILLE 704-664-5281

IMPROVEMENT PERMIT / ~~CERTIFICATE OF COMPLETION~~ / OPERATION PERMIT / EXISTING SYSTEM INSPECT.

PROPERTY DESCRIPTION NO. 24591 DATE Jan. 28, '97 TAX MAP NO. part of 1LA5 Watershed: ☐ Yes ☐ N

OWNER OR CONTRACTOR Bryan Financial Services PHONE: Business _____ Home _____

ADDRESS 149 Yacht Cove Rd, Mooresville

LOCATION US 21 N TR Valley View on left

SUBDIVISION Oakbrook BLOCK / SECTION _____ LOT 12 LOT AREA .8Ac SITE CLASS. PS DESIGN FLOW 360 gpd L.T.A.R. .13

Septic Tank: 1000 Gallons; STB 825 Date 12-11-96

Pump Tank: _____ Gallons; PT _____ Date _____

Pump Make: _____ Model _____ Serial No. _____

Nitrification Field: No Fields 1 Square Feet 1200 Linear Feet 400

No Lines 4@100' Trench Width 36" Max Trench Bottom Depth 18" Gravel Depth 12"

☑ New System ☐ Repair System Type: I, II, III, IV, V, VI

System Description: * Shallow gravity conventional

Repair System Description: pumped shallow conv.

Maintenance Agreement Required: ☐ Yes ☑ No

☑ House/Mod. Home No. Bedrooms 3

☐ Mobile Home No. Bathrooms 2

☐ Business No. Employees _____

☐ Other _____


☐ Slab ☑ Crawl Space ☐ Basement w/plumbing ☐ Basement wo/plumbing

Water Supply: ☑ Individual ☐ Community ☐ Public

Comments: * Plumbing must exit house at or slightly above existing grade to avoid use of a pump. Backfill against foundation as needed.

Comments:

INITIAL SITE SKETCH

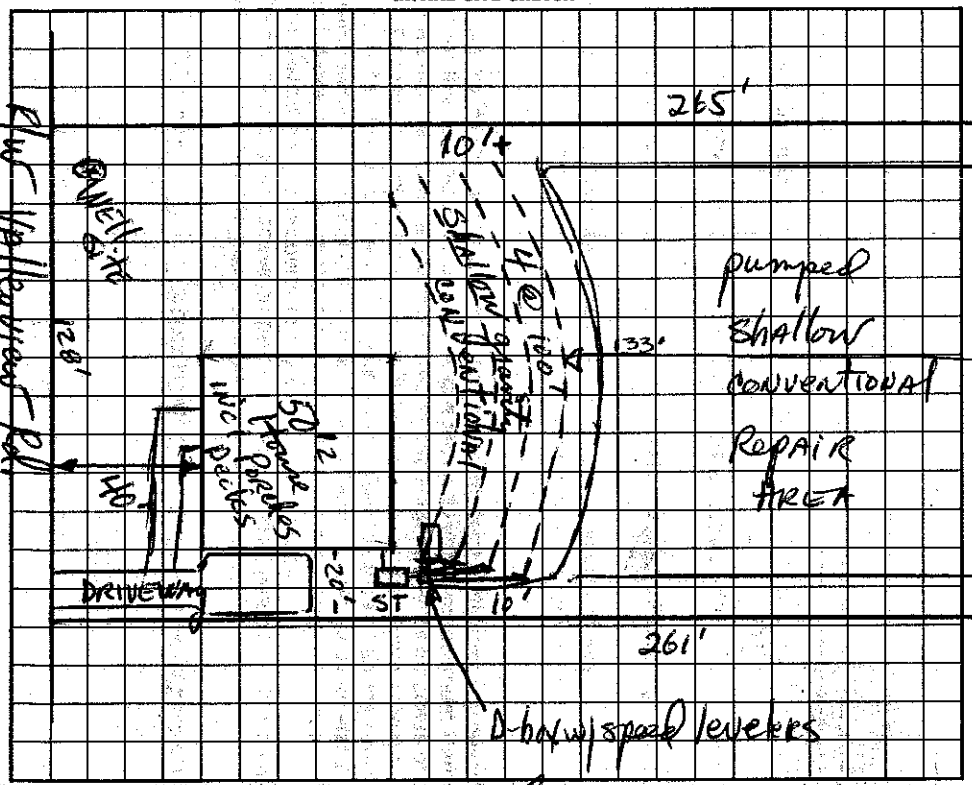


AS BUILT SKETCH

The proposed / existing WHEEL CHAIR RAMP addition does not appear to impact the existing septic system.

**NOTE: _____ REHS

Date: 3-31-10

ICHD-Environmental Health Division

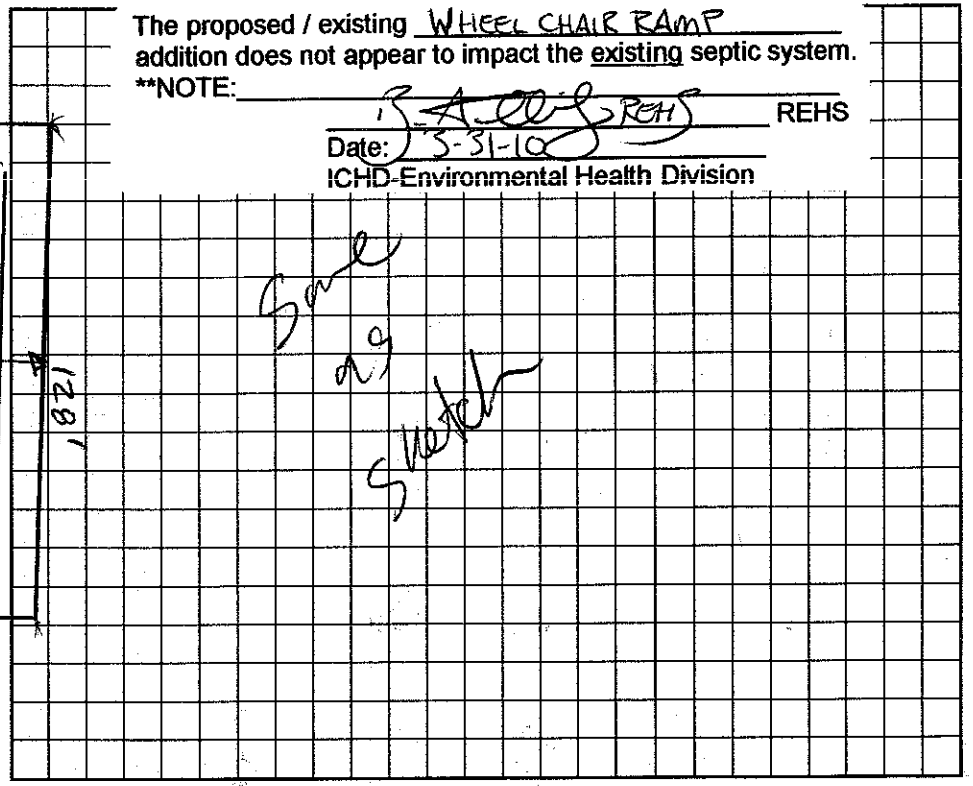

I understand that this permit can be suspended or revoked if any false information is supplied toward securing the permit/any unauthorized changes are made to the site/any unauthorized changes are made in the installation of the system. This Improvement Permit is valid for 60 months from date of issuance.

Installed by: ROWAN SEPTIC

Certificate of Completion by: _____ date _____

Operation Permit by: _____ date 3/7/97

RS date 1-28-97

RS date 1-28-97

INSPECTION COPY (FINAL): GREEN OWNER COPY (FINAL): YELLOW INSPECTION COPY (INITIAL): PINK OWNER COPY (INITIAL): GOLD