IREDELL COUNTY HEALTH DEPARTMENT

Const. Auth. STATESVILLE 704-878-5305 MOORESVILLE 704-664-5281

IMPROVEMENT PERMIT / ~~CERTIFICATE OF COMPLETION~~ / OPERATION PERMIT / EXISTING SYSTEM INSPECTION

PROPERTY DESCRIPTION NO. 24590 DATE Jan. 24, '97 TAX MAP NO. part of 1LA5 4658 10 3624 Watershed: ☑ Yes ☐ No

OWNER OR CONTRACTOR Raeon Financial Services PHONE: Business 664-3671 Home

ADDRESS 149 Yacht Cove Rd, Mooresville

LOCATION 21N TL Valleyview Rd on left

SUBDIVISION Oakbrook BLOCK / SECTION LOT 11 LOT AREA .85 Ac SITE CLASS PS DESIGN FLOW 360gpd L.T.A.R. -3

Septic Tank: 1000 Gallons; STB 825 Date 12/21/96

Pump Tank: 1000 Gallons; PT 47 Date 2/5/97

Pump Make: Model Serial No.

Nitrification Field: No Fields 1 Square Feet 1200 Linear Feet 400

No Lines 4@100' Trench Width 36" Max Trench Bottom Depth 18" Gravel Depth 12"

☑ New System ☐ Repair System Type: I, II, (III), IV, V, VI

System Description: pumped-pm- conventional

Repair System Description: Same

Maintenance Agreement Required: ☐ Yes ☑ No

☑ House/Mod. Home No. Bedrooms 3

☐ Mobile Home No. Bathrooms 2

☐ Business No. Employees

☐ Other

☐ Slab ☑ Crawl Space ☐ Basement w/plumbing ☐ Basement wo/plumbing


Water Supply: ☑ Individual ☐ Community ☐ Public

Comments: 510
55
51
49


Comments: LINES, TANKS, PRESSURE CHECKED 3/24/97

1" = 50'

INITIAL SITE SKETCH

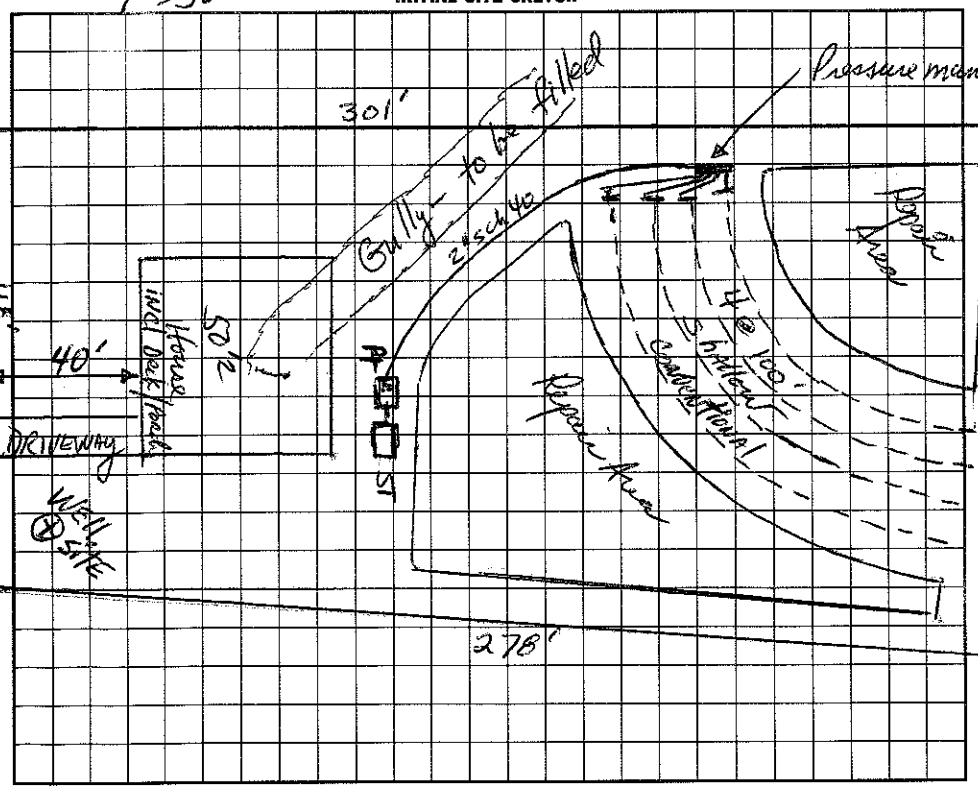

AS BUILT SKETCH

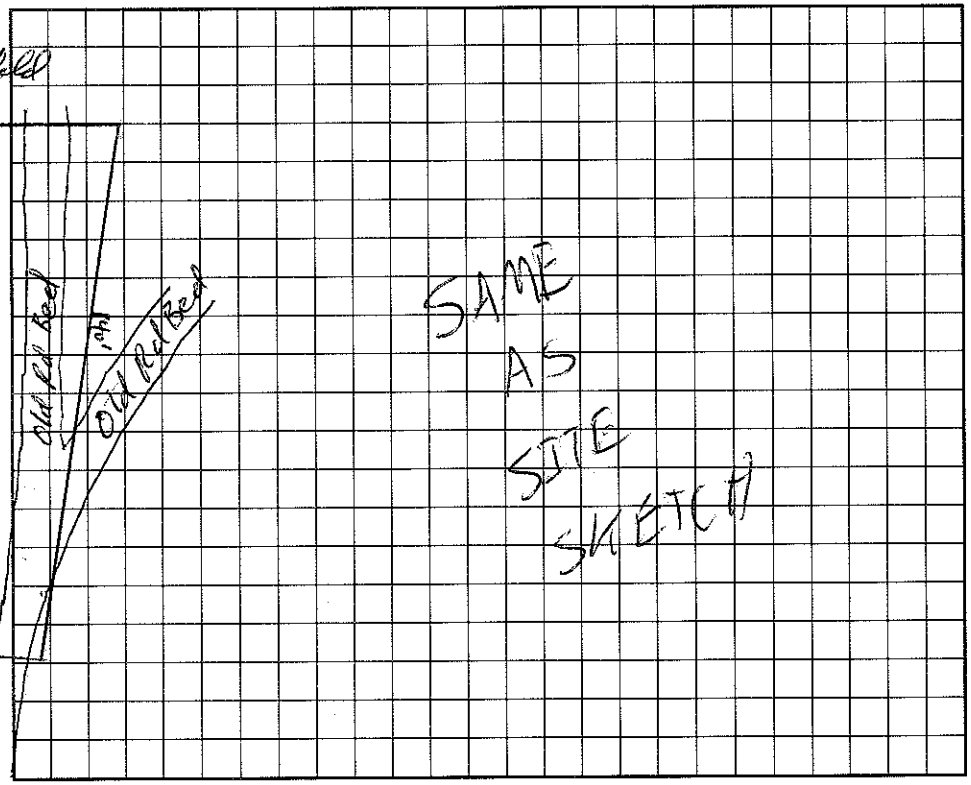

I understand that this permit can be suspended or revoked if any false information is supplied toward securing the permit/any unauthorized changes are made to the site/any unauthorized changes are made in the installation of the system. Improvement Permit is valid for 60 months from date of issuance.

Signed: X

Improvement Permit by: RS date 1-24-97

Construction ~~Existing System Inspection~~ by: RS date 1-24-97

Authorization

Installed by: ROWAN SEPTIC

Certificate of Completion by: Wesley Sparks R.S. date 5/14/97

Operation Permit by: Wesley Sparks R.S. date 5/14/97

HEALTH DEPT. COPY: WHITE INSPECTION COPY (FINAL): GREEN OWNER COPY (FINAL): YELLOW INSPECTION COPY (INITIAL): PINK OWNER COPY (INITIAL): GOLD