IREDELL COUNTY HEALTH DEPARTMENT Const. Auth

STATESVILLE 704-878-5305 MOORESVILLE 704-664-5281

IMPROVEMENT PERMIT / ~~CERTIFICATE OF COMPLETION~~ / OPERATION PERMIT / EXISTING SYSTEM INSPECTION

PROPERTY DESCRIPTION NO. 24634 DATE April 17, '97 TAX MAP NO. part of 1145 Watershed: ☑ Yes ☐ No

OWNER OR CONTRACTOR Kron Financial Services PHONE: Business _____ Home _____

ADDRESS 149 Yacht Cove Road Mooresville

LOCATION 2.1 N of Valleyview on Right before Lismark

SUBDIVISION Oakbrook BLOCK / SECTION _____ LOT 55 LOT AREA .66 ac SITE CLASS. FS DESIGN FLOW 360 gpd L.T.A.R. .3

Septic Tank: 1000 Gallons; STB 825 Date 5/13/97

Pump Tank: _____ Gallons; PT _____ Date _____

Pump Make: _____ Model _____ Serial No. _____

Nitrification Field: No. Fields 1 Square Feet 1200 Linear Feet 400

No. Lines 4@100' Trench Width 36" Max Trench Bottom Depth 24" Gravel Depth 12"

☑ New System ☐ Repair System Type: I, (II), III, IV, V, VI

System Description: gravity conventional

Repair System Description same / pumped chamber

Maintenance Agreement Required: ☐ Yes ☑ No

☑ House/Mod. Home No. Bedrooms 3

☐ Mobile Home No. Bathrooms 2

☐ Business No. Employees _____

☐ Other _____

☑ Slab ☐ Crawl Space ☐ Basement w/plumbing ☐ Basement wo/plumbing


Water Supply: ☑ Individual ☐ Community ☐ Public

Comments:

Comments:

1"=50'

INITIAL SITE SKETCH

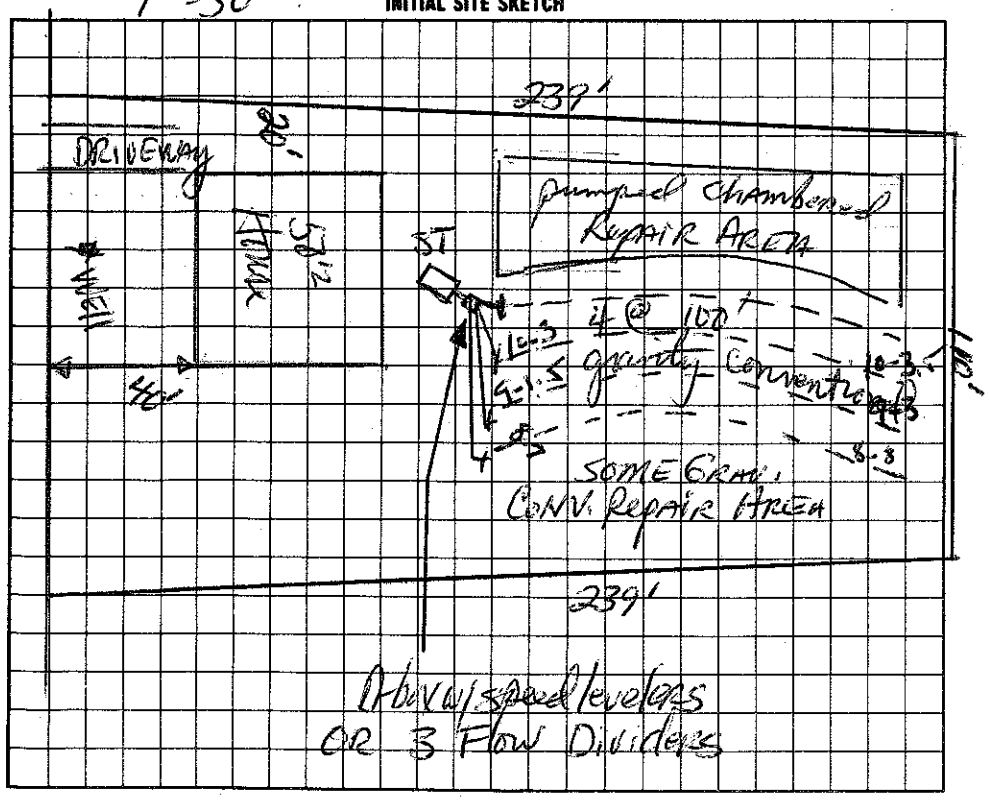

AS BUILT SKETCH

I understand that this permit can be suspended or revoked if any false information is supplied toward securing the permit/any unauthorized changes are made to the site/any unauthorized changes are made in the installation of the system.

Signed: _____

Improvement Permit by: _____ date 4/17/97

~~Existing System Inspection by:~~ _____ date 4/17/97

Authorization CONSTRUCTION

Installed by: Rowan Septic Tank

Certificate of Completion by: _____ date 6/23/97

Operation Permit by: _____ date 6/23/97

HEALTH DEPT. COPY: WHITE INSPECTION COPY (FINAL): GREEN OWNER COPY (FINAL): YELLOW INSPECTION COPY (INITIAL): PINK OWNER COPY (INITIAL): GOLD