IREDELL COUNTY HEALTH DEPARTMENT

STATESVILLE 704-878-5305 MOORESVILLE 704-664-5281

IMPROVEMENT PERMIT / AUTHORIZATION TO CONSTRUCT / OPERATION PERMIT / EXISTING SYSTEM INSPECTION

PERMIT# 119813 PIN# 4658 10 3954 DATE 3/22/04

OWNER OR CONTRACTOR Cecil & Mary Luty PHONE: Business 301-0525 ~~Home~~ 4658-10-39 54

ADDRESS 206 Valleyview Rd. Mooresville, NC. 28117

LOCATION 21 N TL Valleyview to #206 on R

SUBDIVISION OAKBROOK BLOCK / SECTION ____ LOT 55 LOT AREA .66AC SITE CLASS. PS DESIGN FLOW 360 L.T.A.R. .3

Septic Tank: EXISTING Gallons; STB ____ Date ____

Pump Tank: ____ Gallons; PT ____ Date ____

Pump Make: ____ Model ____ Serial No. ____

Nitrification Field: No Fields 5 Square Feet Existing 5 Linear Feet ____

No Lines ____ Trench Width ____ Max Trench Bottom Depth ____ Gravel Depth ____

☐ New System ☐ Repair System Type: I ☐ II, III, IV, V, VI

System Description: EXISTING SYSTEM

Repair System Description: 16" PPBPS - Pumped

Maintenance Agreement Required: ☐ Yes ☒ No

☒ House/Mod. Home No. Bedrooms 3

☐ Mobile Home No. Bathrooms 2

☐ Business No. Employees ____

☐ Other ____


☐ Slab ☐ Crawl Space ☐ Basement w/plumbing ☐ Basement wo/plumbing

Water Supply: ☒ Individual ☐ Public ☐ Community

Comments:/Conditions:

Comments:/Conditions: Building is not over drainfield

INITIAL SITE SKETCH

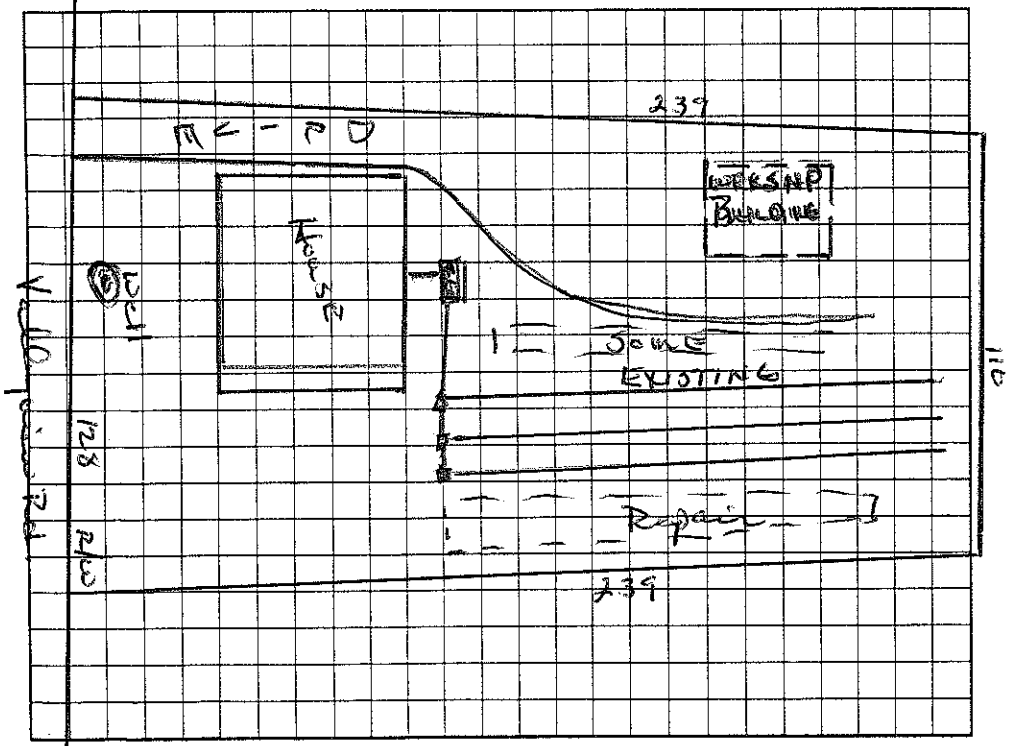

AS BUILT SKETCH

Permit can be suspended or revoked if any false information is supplied toward securing the permit/any unauthorized changes are made to the site/any unauthorized changes are made in the installation of the system. Improvement Permit with plat valid without expiration. Improvement Permit with site plan valid for sixty months. Authorization to Construct is valid for a period equal to that of Improvement Permit – not to exceed sixty months.

Signed: x Cecil R. Luty date ____ Installed by: Rowan Septic Tank

Improvement Permit by: ____ date ____ Operation Permit by: ____ date ____

Authorization to Construct by: ____ date ____ Existing System Inspection by: Wesley Sparks RS. date 3/22/04

HEALTH DEPT. COPY: WHITE OWNER COPY (FINAL): YELLOW OWNER COPY (INITIAL): PINK