IREDELL COUNTY HEALTH DEPARTMENT Cont. Auth. STATESVILLE 704-878-5305 MOORESVILLE 704-664-5281

IMPROVEMENT PERMIT / ~~CERTIFICATE OF COMPLETION~~ / OPERATION PERMIT / EXISTING SYSTEM INSPECTION

PROPERTY DESCRIPTION NO. 24589 DATE Jan 30, '97 TAX MAP NO. part of 16A5 Watershed: ☑ Yes ☐ No

OWNER OR CONTRACTOR Rowan Financial Services PHONE: Business 4658-10-4652 Home

ADDRESS 149 Yacht Rd, Mooresville

LOCATION US 21 N. TL Valleyview on left

SUBDIVISION Oakbrook BLOCK / SECTION LOT 10 LOT AREA .95Ac SITE CLASS. FS DESIGN FLOW 360gpd L.T.A.R. .3

Septic Tank: 1000 Gallons; STB 825 Date 3/10/97

Pump Tank: Gallons; PT Date

Pump Make: Model Serial No.

Nitrification Field: No Fields 2 Square Feet 1200 Linear Feet 400

No Lines 3+3 Trench Width 36" Max Trench Bottom Depth 18" Gravel Depth 12"

☑ New System ☐ Repair System Type: I, II, III, IV, V, VI

System Description: Shallow gravity conventional

Repair System Description: gravity pumped conventional

Maintenance Agreement Required: ☐ Yes ☑ No

☑ House/Mod. Home No. Bedrooms 3

☐ Mobile Home No. Bathrooms 2

☐ Business No. Employees

☐ Other

☐ Slab ☑ Crawl Space ☐ Basement w/plumbing ☐ Basement wo/plumbing


Water Supply: ☑ Individual ☐ Community ☐ Public

Comments:

Comments:

1"=50'

INITIAL SITE SKETCH

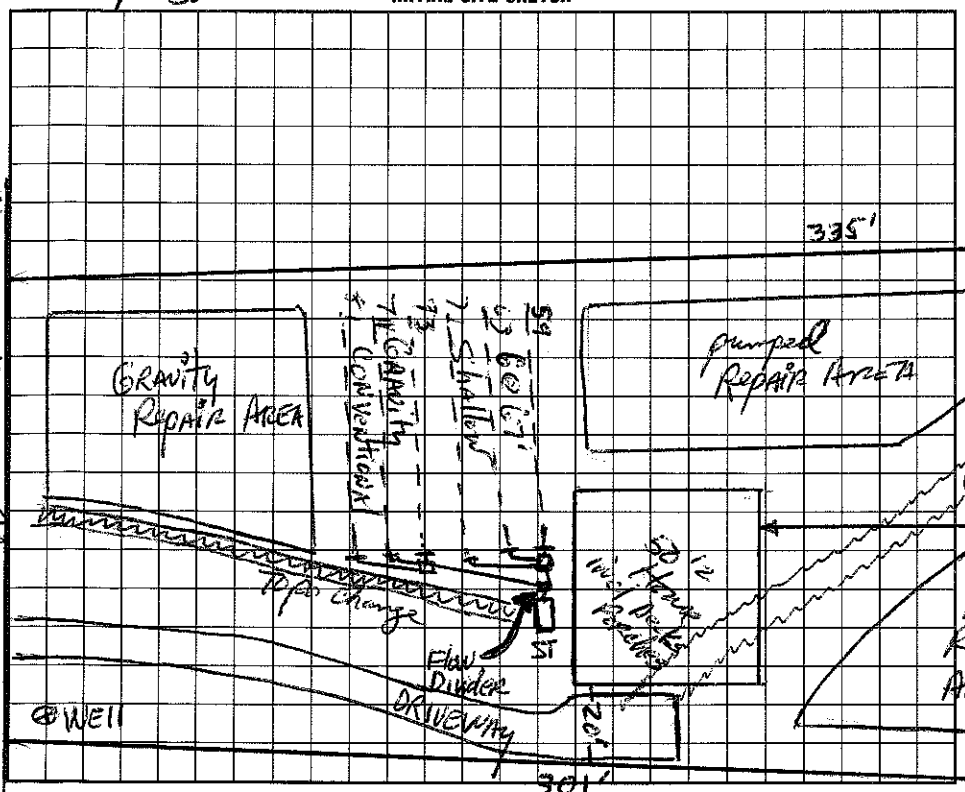

AS BUILT SKETCH

Same As Site Sketch

I understand that this permit can be suspended or revoked if any false information is supplied toward securing the permit/any unauthorized changes are made to the site/any unauthorized changes are made in the installation of the system. Improvement Permit is valid for 60 months from date of issuance.

Signed:

Improvement Permit by: RS date 1-30-97

~~Construction~~ ~~Closing System Inspection~~ by: RS date 1-30-97

Authorization

Installed by: ROWAN SEPTIC

Certificate of Completion by: date

Operation Permit by: EHS date 5/1/97

HEALTH DEPT. COPY: WHITE INSPECTION COPY (FINAL): GREEN OWNER COPY (FINAL): YELLOW INSPECTION COPY (INITIAL): PINK OWNER COPY (INITIAL): GOLD