(4.00)

IREDELL COUNTY HEALTH DEPARTMENT

Const. Auth. STATESVILLE 704-878-5305 MOORESVILLE 704-664-5281

IMPROVEMENT PERMIT / ~~CERTIFICATE OF COMPLETION~~ / OPERATION PERMIT / EXISTING SYSTEM INSPECTION

PROPERTY DESCRIPTION NO. 24588 DATE Feb 14, 97 TAX MAP NO. part of ILAS 4658 10 5791 Watershed: ☑ Yes ☐ No

OWNER OR CONTRACTOR Krom Financial Services PHONE: Business _____ Home _____

ADDRESS 149 Yacht Cove Rd Mooresville

LOCATION 2.1 N Jct Valleyview Rd. on left past Patrose Ln.

SUBDIVISION Oakbrook BLOCK / SECTION _____ LOT 9 LOT AREA .96 Ac SITE CLASS. PS DESIGN FLOW 360gpd L.T.A.R. .3

Septic Tank: 1000 Gallons; STB 825 Date 7/2/97

Pump Tank: 1000 Gallons; PT 47 Date 8/2/97

Pump Make: ZOELLER Model N-98B Serial No. _____

Nitrification Field: No Fields 1 Square Feet 1200 Linear Feet 400

No Lines 5 Trench Width 36" Max Trench Bottom Depth (18") Gravel Depth 12"

☑ New System ☐ Repair System Type: I, II, (III), IV, V, VI

System Description: pumped-pm-shallow conventional

Repair System Description: Same

Maintenance Agreement Required: ☐ Yes ☑ No

☑ House/Mod. Home ☐ Mobile Home ☐ Business ☐ Other

No. Bedrooms 3 No. Bathrooms 2 No. Employees _____


☑ Slab ☐ Crawl Space ☐ Basement w/plumbing ☐ Basement wo/plumbing

Water Supply: ☑ Individual ☐ Community ☐ Public


Comments: 4 taps on pressure manifold. Upper tap to go to flow divider.

Comments:

INITIAL SITE SKETCH 1" = 100'

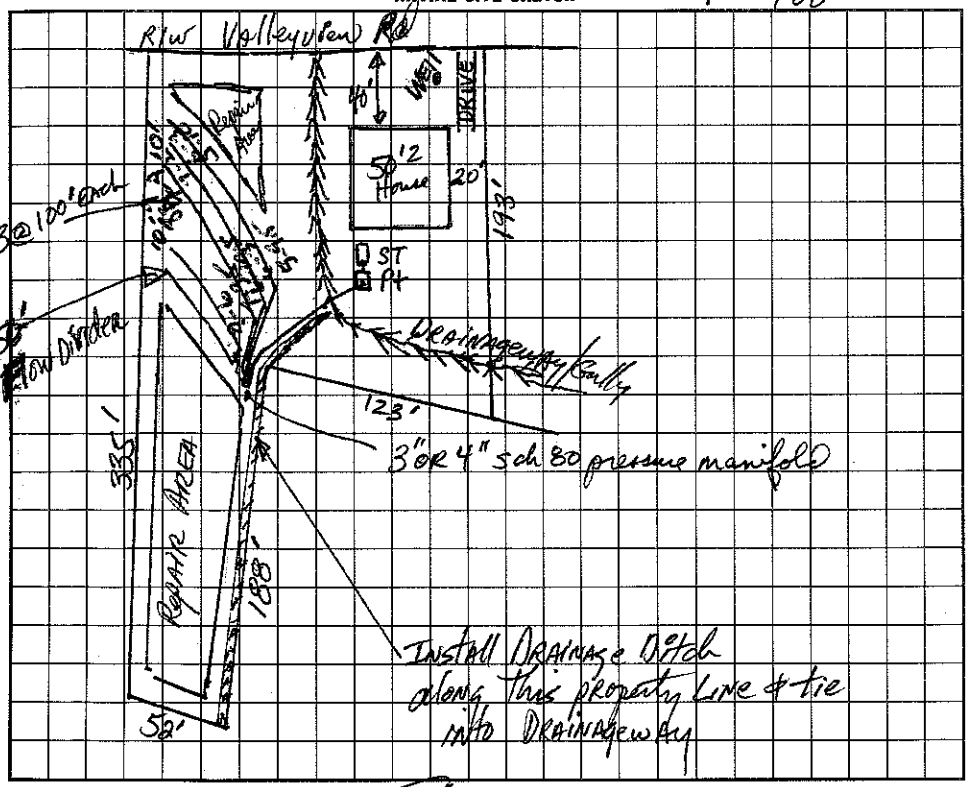

AS BUILT SKETCH

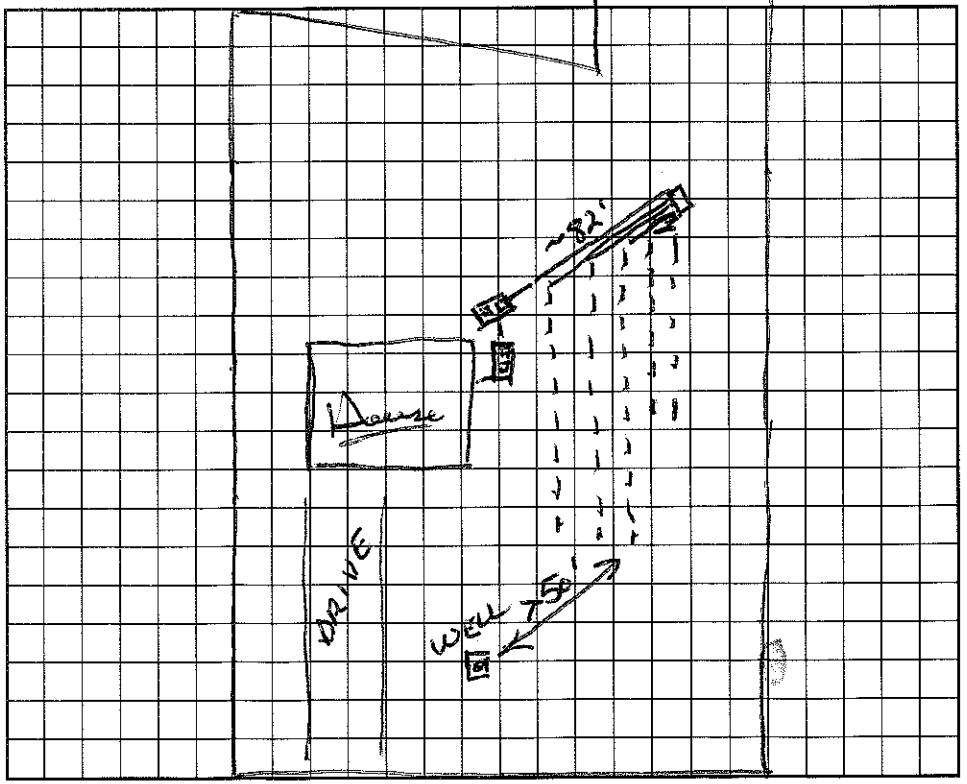

I understand that this permit can be suspended or revoked if any false information is supplied toward securing the permit/any unauthorized changes are made to the site/any unauthorized changes are made in the installation of the system. Improvement Permit is valid for 60 months from date of issuance.

Signed: _____

Improvement Permit by: _____ date 2-14-97

CONSTRUCTION ~~Existing System Inspection by~~: _____ date 2-14-97

AUTHORIZATION

Installed by: VALLEYVIEW DR Rowan Septic Tank

Certificate of Completion by: Wesley Sparks RS. date 9/10/97

Operation Permit by: Wesley Sparks RS date 9/10/97

HEALTH DEPT. COPY: WHITE INSPECTION COPY (FINAL): GREEN OWNER COPY (FINAL): YELLOW INSPECTION COPY (INITIAL): PINK OWNER COPY (INITIAL): GOLD