(3; 30)

IREDELL COUNTY HEALTH DEPARTMENT Const. Auth STATESVILLE 704-878-5305 MOORESVILLE 704-664-5281

IMPROVEMENT PERMIT / ~~CERTIFICATE OF COMPLETION~~ / OPERATION PERMIT / EXISTING SYSTEM INSPECTION

PROPERTY DESCRIPTION NO. 24635 DATE April 25, '97 TAX MAP NO. part of 1LA5 Watershed: ☑ Yes ☐ No

OWNER OR CONTRACTOR Krom Financial Services PHONE: Business ~~Home~~ 4658-10-59/5

ADDRESS 149 Yacht Cove Rd, Mooresville

LOCATION 21 N. TL Valleyview Rd. on Right before Lismark Dr.

SUBDIVISION Oakbrook BLOCK / SECTION ____ LOT 56 LOT AREA 1.1 Ac SITE CLASS 15 gpd, 1944d DESIGN FLOW 360 gpd L.T.A.R. .4

Septic Tank: 1000 Gallons; STB 525 Date 9/1/97

Pump Tank: ____ Gallons; PT ____ Date ____

Pump Make: ____ Model ____ Serial No. ____

Nitrification Field: No Fields 1 Square Feet 900 * Linear Feet 300 *

No Lines 3 Trench Width 36" ~~Max~~ Trench Bottom Depth 42" * Gravel Depth 12" + 18" Sand

☑ New System ☐ Repair System Type: I, II, III, IV, V, VI

System Description: Sand Lined Cond. Trenches

Repair System Description: Same

Maintenance Agreement Required: ☐ Yes ☑ No

☑ House/Mod. Home No. Bedrooms 3

☐ Mobile Home No. Bathrooms 2

☐ Business No. Employees ____

☐ Other ____


☐ Slab ☑ Crawl Space ☐ Basement w/plumbing ☐ Basement wo/plumbing

Water Supply: ☐ Individual ☐ Community ☐ Public


Comments: WELL MUST BE 100' MINIMUM FROM SAND LINED TRENCHES.

Comments: SYSTEM CHANGED PER TOVE + JACOBS

INITIAL SITE SKETCH

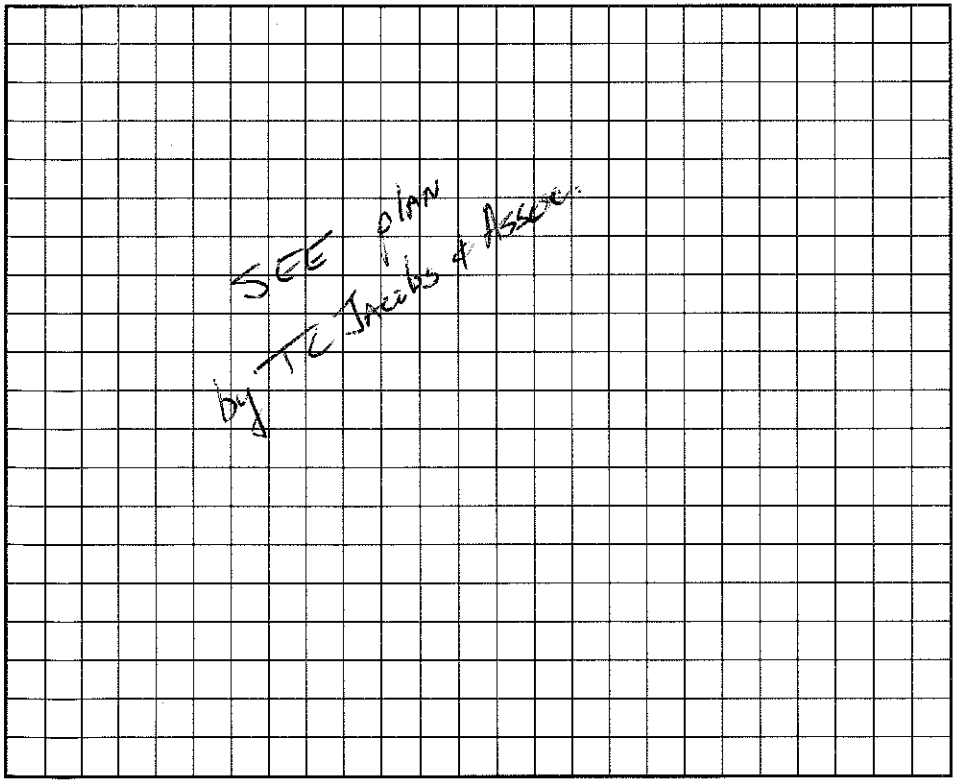

AS BUILT SKETCH

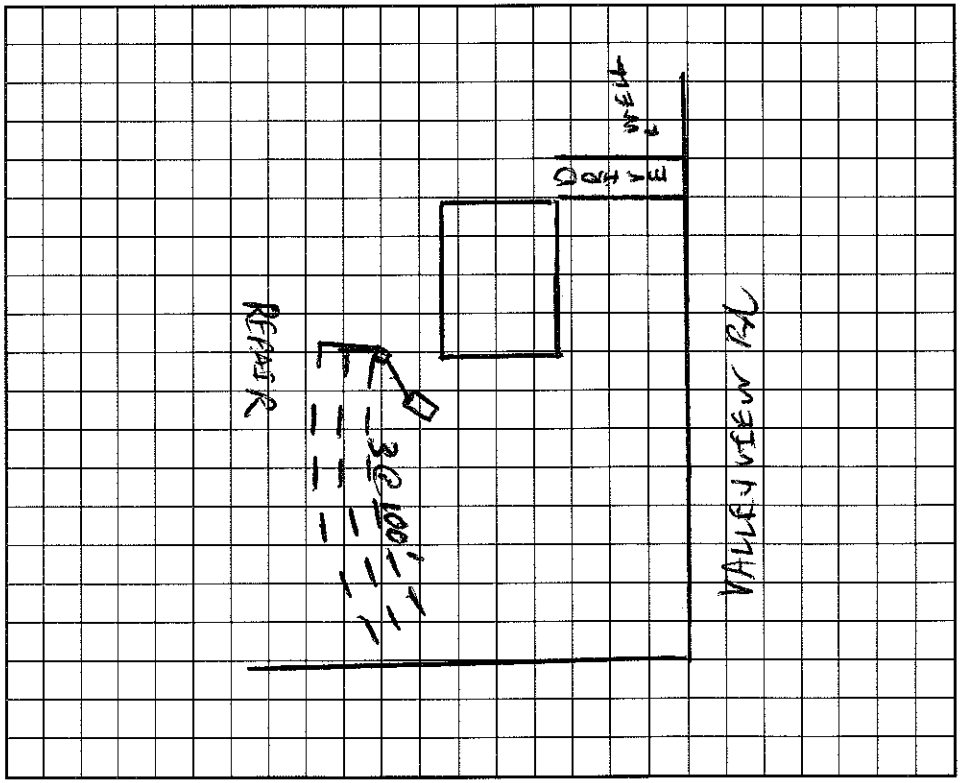

I understand that this permit can be suspended or revoked if any false information is supplied toward securing the permit/any unauthorized changes are made to the site/any unauthorized changes are made in the installation of the system. Improvement Permit is valid for 60 months from date of issuance.

Signed: A Sowell

Improvement Permit by: DK Freeman, RS date 4/30/97

~~Construction~~ Existing System Inspection by: DK Freeman, RS date 4/30/97

Authorization

Installed by: ROWAN SEPTIC

Certificate of Completion by: ____ date ____

Operation Permit by: C Brady Freeman RS date 10/23/97

HEALTH DEPT. COPY: WHITE INSPECTION COPY (FINAL): GREEN OWNER COPY (FINAL): YELLOW INSPECTION COPY (INITIAL): PINK OWNER COPY (INITIAL): GOLD