IREDELL COUNTY HEALTH DEPARTMENT

STATESVILLE 704-878-5305 MOORESVILLE 704-664-5281

IMPROVEMENT PERMIT / ~~CERTIFICATE OF COMPLETION~~ / OPERATION PERMIT / EXISTING SYSTEM INSPECTIO

PROPERTY DESCRIPTION NO. 24587 DATE Aug 18, '97 TAX MAP NO. part of 1LA5 4658 10 7763 Watershed: ☑ Yes ☐ No

OWNER OR CONTRACTOR Kpom financial Services PHONE: Business 664-3671 Home

ADDRESS 149 Yadkin Cove Rd. Mooresville

LOCATION US21 N. TL Valleyview on left across from Patrose

SUBDIVISION Oakbrook BLOCK / SECTION LOT 8 LOT AREA .68AC SITE CLASS. B DESIGN FLOW 360gpd L.T.A.R. .3

Septic Tank: 1000 Gallons; STB 525 Date 8/16/97

Pump Tank: 1000 Gallons; PT 47 Date 9/17/97

Pump Make: ~~OREUER~~ Model M137 Serial No.

Nitrification Field: No Fields 1 Square Feet 720 Linear Feet 400

No Lines 4@100' Trench Width 36" Max Trench Bottom Depth ~18" Gravel Depth 12"

☑ New System ☐ Repair System Type: I, II, III, IV, V, VI

System Description: pumped pressure conventional

Repair System Description: same

Maintenance Agreement Required: ☐ Yes ☑ No

☐ House/Mod. Home No. Bedrooms 3

☐ Mobile Home No. Bathrooms 2

☐ Business No. Employees

☐ Other

☑ Slab ☐ Crawl Space ☐ Basement w/plumbing ☐ Basement wo/plumbing

Water Supply: ☑ Individual ☐ Community ☐ Public


Comments:

Comments: LINES, TANKS, PRESSURE - NO FLOATS

PANEL REPAIR

1"=100'

INITIAL SITE SKETCH

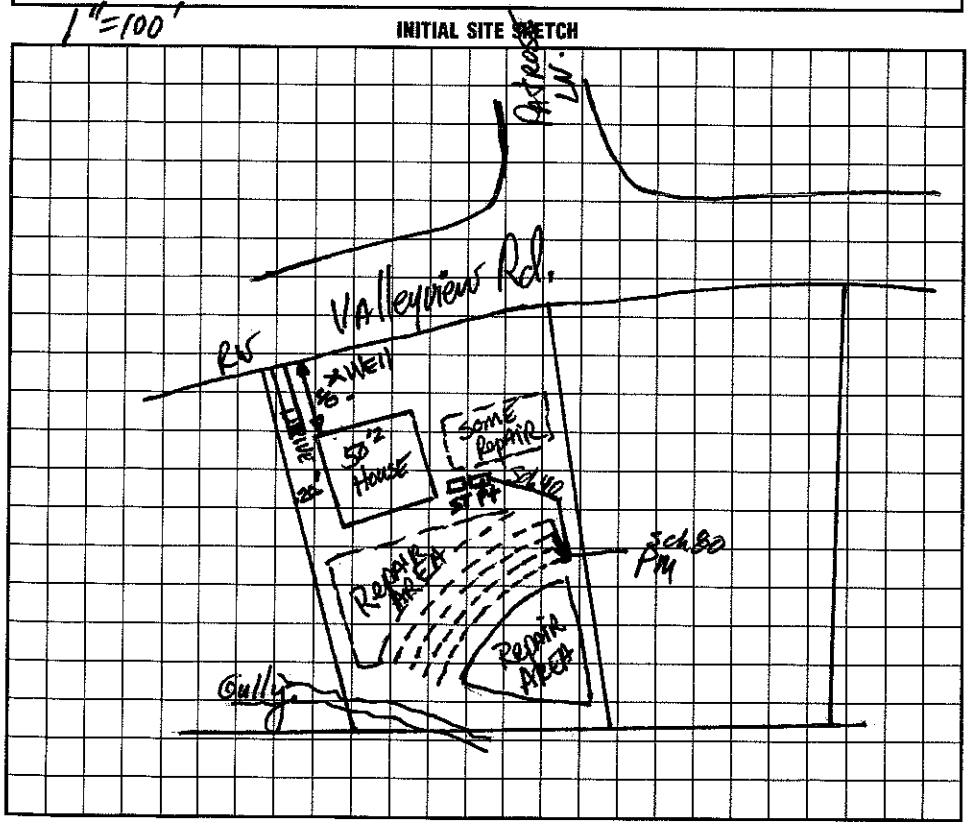

AS BUILT SKETCH

I understand that this permit can be suspended or revoked if any false information is supplied toward securing the permit/any unauthorized changes are made to the site/any unauthorized changes are made in the installation of the system. Improvement Permit is valid for 60 months from date of issuance.

Signed: X

Improvement Permit by: date 8-18-97

~~Construction~~ Authorization by: date 8-18-97

Installed by: Rowan Septic Tank

Certificate of Completion by: Wesley Sparks RS date 11/14/97

Operation Permit by: Wesley Sparks RS date 11/14/97

HEALTH DEPT. COPY: WHITE INSPECTION COPY (FINAL): GREEN OWNER COPY (FINAL): YELLOW INSPECTION COPY (INITIAL): PINK OWNER COPY (INITIAL): GOLD