IREDELL COUNTY HEALTH DEPARTMENT

Const. Auth STATESVILLE 704-878-5305 MOORESVILLE 704-664-5281

IMPROVEMENT PERMIT / ~~CERTIFICATE OF COMPLETION~~ / OPERATION PERMIT / EXISTING SYSTEM INSPECTION

PROPERTY DESCRIPTION NO. 24636 DATE Feb 13, '97 TAX MAP NO. part of 1LA5 4658 10 7934 Watershed: ☑ Yes ☐ No

OWNER OR CONTRACTOR Ram Financial Services PHONE: Business _____ Home _____

ADDRESS 149 Yacht Cove Rd. Mooresville

LOCATION 21 N. TR Valleyview TR Patrose on left corner lot

SUBDIVISION Oakbrook BLOCK / SECTION _____ LOT 57 LOT AREA .66AC SITE CLASS PS DESIGN FLOW 360gpd L.T.A.R. .35

Septic Tank: 1000 Gallons; STB 825-1000 Date 10/7/97

Pump Tank: 1000 Gallons; PT RST-PT47-106 Date _____

Pump Make: A4020 Model ME50 Serial No. _____

Nitrification Field: No Fields 1 Square Feet 1080 Linear Feet 360

No Lines 3@120' Trench Width 36" Max Trench Bottom Depth 18" Gravel Depth 12"

☑ New System ☐ Repair System Type: I, II, (III) IV, V, VI

System Description: pumped - pm - shallow conventional

Repair System Description: same

Maintenance Agreement Required: ☐ Yes ☑ No

☑ House/Mod. Home No. Bedrooms 3

☐ Mobile Home No. Bathrooms 2

☐ Business No. Employees _____

☐ Other _____

☑ Slab ☐ Crawl Space ☐ Basement w/plumbing ☐ Basement wo/plumbing


Water Supply: ☑ Individual ☐ Community ☐ Public

Comments:

Comments:

1" = 100'

INITIAL SITE SKETCH

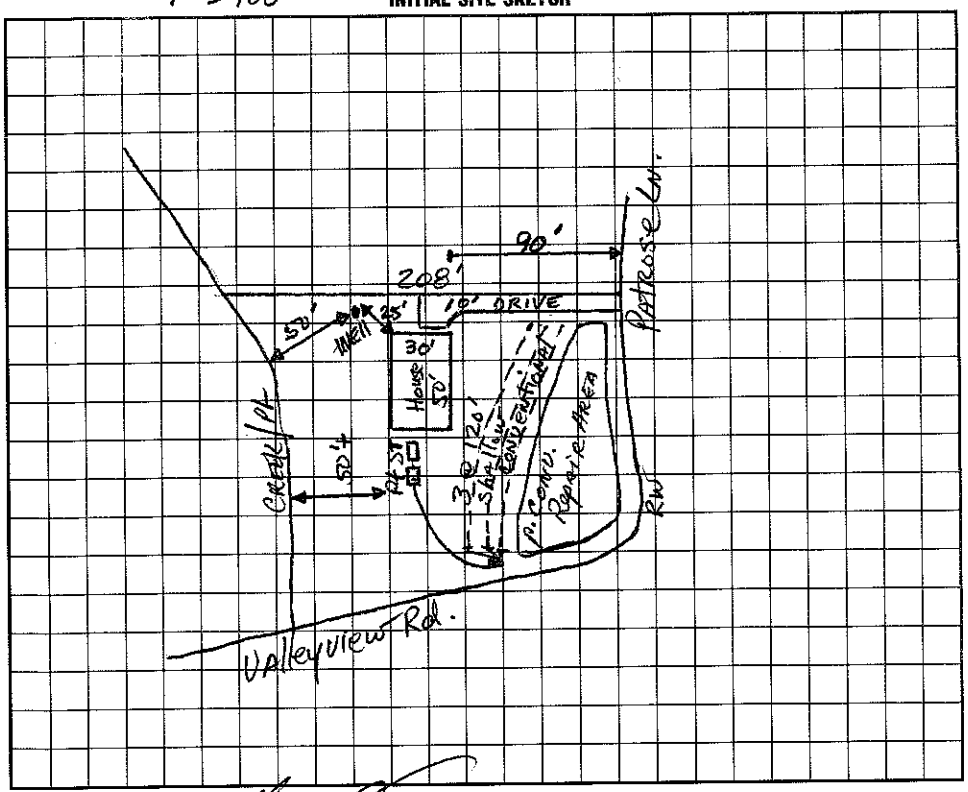

AS BUILT SKETCH

I understand that this permit can be suspended or revoked if any false information is supplied toward securing the permit/any unauthorized changes are made to the site/any unauthorized changes are made in the installation of the system. Improvement Permit is valid for 60 months from date of issuance.

Signed: _____

Improvement Permit by: _____ date 2-13-97

~~Existing System Inspection~~ Construction Authorization by: _____ date 2-13-97

installed by: ROWAN SEPTIC

Certificate of Completion by: _____ date _____

Operation Permit by: _____ date 7/24/98

HEALTH DEPT. COPY: WHITE INSPECTION COPY (FINAL): GREEN OWNER COPY (FINAL): YELLOW INSPECTION COPY (INITIAL): PINK OWNER COPY (INITIAL): GOLD