4:00

IREDELL COUNTY HEALTH DEPARTMENT Const. Auth. STATESVILLE 704-878-5305 MOORESVILLE 704-664-5281

IMPROVEMENT PERMIT / ~~CERTIFICATE OF COMPLETION~~ / OPERATION PERMIT / EXISTING SYSTEM INSPECTION

PROPERTY DESCRIPTION NO. 24586 DATE March 19, '97 TAX MAP NO. part of 1LA5 4658 10 9704 Watershed: ☑ Yes ☐ No

OWNER OR CONTRACTOR Dixon Financial Services PHONE: Business 664-3671 Home

ADDRESS 149 Yacht Cove Rd, Mooresville

LOCATION Hwy 21 No. TL Valleyview Rd. on left

SUBDIVISION Oakcroft BLOCK / SECTION LOT 7 LOT AREA .97AC / SITE CLASS. A5 DESIGN FLOW 360gpd L.T.A.R. .3

Septic Tank: 1000 Gallons; STB 825 Date 5/11/97

Pump Tank: 1000 Gallons; PT 47 Date 6/29/97

Pump Make: ZOELLER Model N137 Serial No.

Nitrification Field: No. Fields 1 Square Feet 1200 Linear Feet 400

No. Lines 4@100' Trench Width 36" Max Trench Bottom Depth 24" Gravel Depth 12"

☑ New System ☐ Repair System Type: I, II, (III), IV, V, VI

System Description: pumped pressure Conventional

Repair System Description: Same

Maintenance Agreement Required: ☐ Yes ☑ No

☑ House/Mod. Home No. Bedrooms 3

☐ Mobile Home No. Bathrooms 2

☐ Business No. Employees

☐ Other

☑ Slab ☐ Crawl Space ☐ Basement w/plumbing ☐ Basement wo/plumbing


Water Supply: ☑ Individual ☐ Community ☐ Public

Comments:


Comments:
New 4X Box & Alarm box Checked 8/14/97 MPO

1" = 50'

INITIAL SITE SKETCH

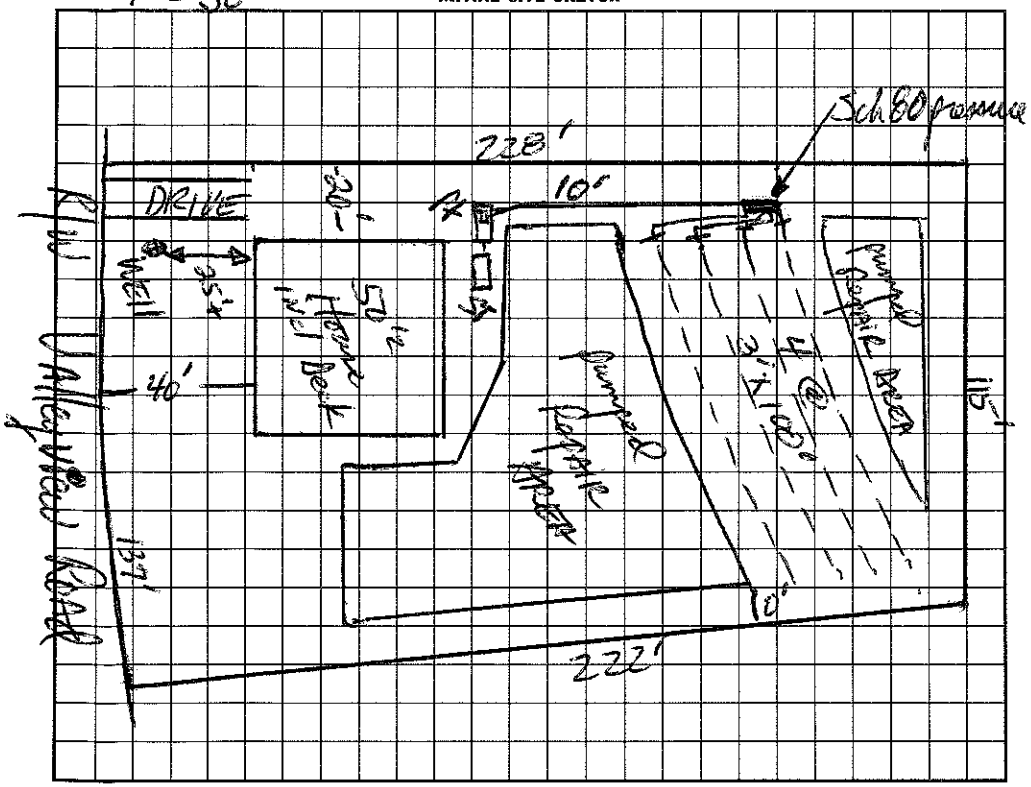

AS BUILT SKETCH

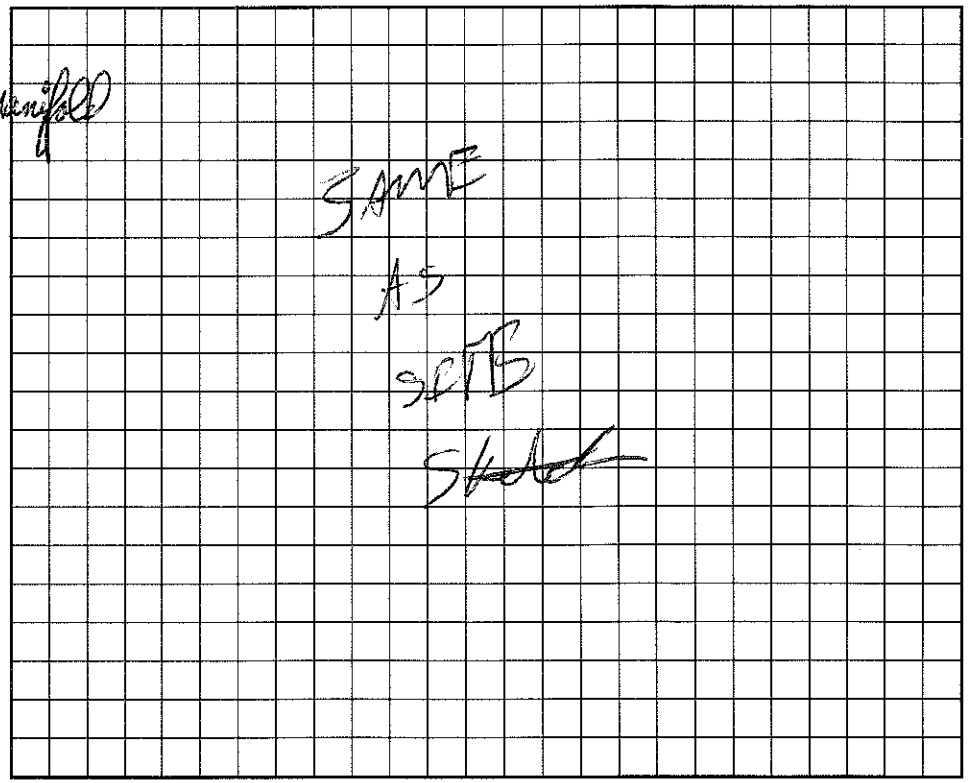

I understand that this permit can be suspended or revoked if any false information is supplied toward securing the permit/any unauthorized changes are made to the site/any unauthorized changes are made in the installation of the system. Improvement Permit is valid for 60 months from date of issuance.

Signed:

Improvement Permit by: D Hinson, RS date 3/19/97

~~Existing System Inspection by:~~ Construction Authorization D Hinson, RS date 3/19/97

Installed by: ROWAN SEPTIC

Certificate of Completion by: Maria H. Watson date 8/14/97

Operation Permit by: Maria H. Watson date 8/14/97

HEALTH DEPT. COPY: WHITE INSPECTION COPY (FINAL): GREEN OWNER COPY (FINAL): YELLOW INSPECTION COPY (INITIAL): PINK OWNER COPY (INITIAL): GOLD