# IREDELL COUNTY HEALTH DEPARTMENT

Const. Auth. STATESVILLE 704-878-5305 MOORESVILLE 704-664-5281

## IMPROVEMENT PERMIT / ~~CERTIFICATE OF COMPLETION~~ / OPERATION PERMIT / EXISTING SYSTEM INSPECTION

PROPERTY DESCRIPTION NO. 24632 DATE April 28, '97 TAX MAP NO. part of 12A5 Watershed: ☐ Yes ☐ No

OWNER OR CONTRACTOR Kwon Financial Services PHONE: Business ~~Home~~ 4658-11-3140

ADDRESS 149 Yacht Cove Rd, Mooresville

LOCATION 21N. TL Valleyview TR Lismark on Right

SUBDIVISION Oakbrook BLOCK / SECTION LOT 53 LOT AREA 1.08 Ac SITE CLASS. PS DESIGN FLOW 360gpd L.T.A.R. .3

Septic Tank: 1000 Gallons; STB ~~S2S-4SS~~ Date 9/1/97

Pump Tank: Gallons; PT Date

Pump Make: Model Serial No.

Nitrification Field: No Fields 1 Square Feet 1200 Linear Feet 400

No Lines 4@10' Trench Width 36" Max Trench Bottom Depth 18" Gravel Depth 12"

☑ New System ☐ Repair System Type: I, II, III, IV, V, VI

System Description: 4@100' conventional

Repair System Description: same

Maintenance Agreement Required: ☐ Yes ☑ No

☑ Slab ☐ Crawl Space ☐ Basement w/plumbing ☐ Basement wo/plumbing

☑ House/Mod. Home No. Bedrooms 3

☐ Mobile Home No. Bathrooms 2

☐ Business No. Employees

☐ Other


Water Supply:
☑ Individual
☐ Community
☐ Public

Comments:

Comments:

### INITIAL SITE SKETCH

1"=100'

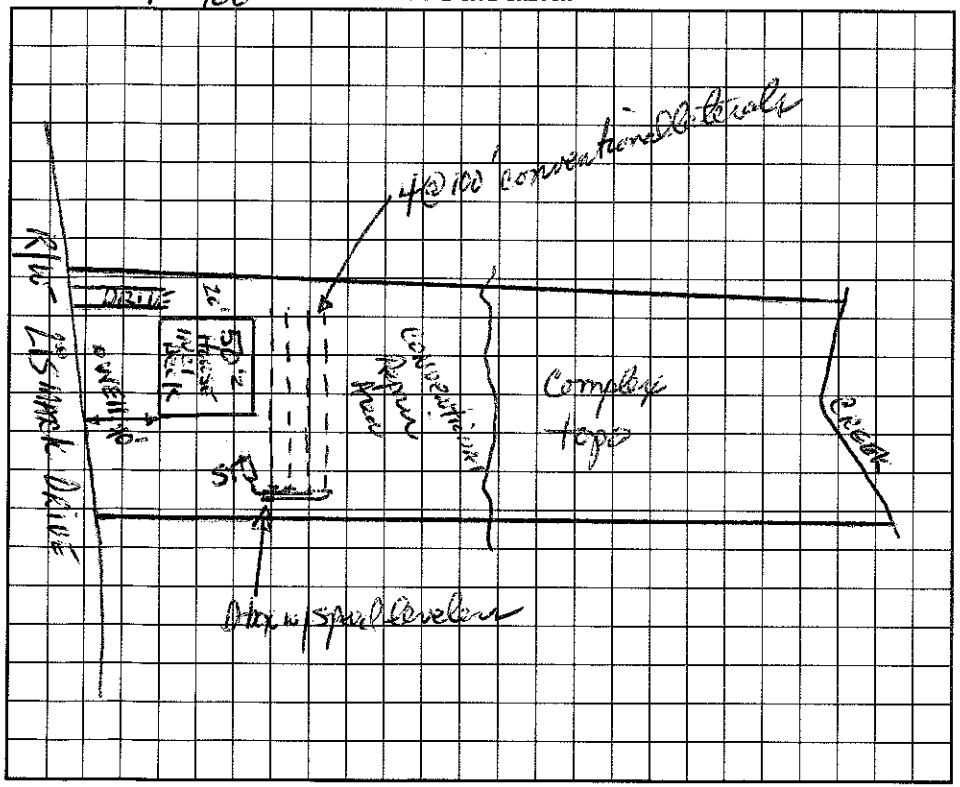


### AS BUILT SKETCH

SAME AS SITE SKETCH

I understand that this permit can be suspended or revoked if any false information is supplied toward securing the permit/any unauthorized changes are made to the site/any unauthorized changes are made in the installation of the system. Improvement Permit is valid for 60 months from date of issuance.

Signed:

Improvement Permit by: R. Freeman, RS date 4/28/97

~~Existing System Inspection~~ by: D. Freeman, RS date 7/28/97

Installed by: ROWAN SEPTIC

Certificate of Completion by: date

Operation Permit by: C. Ray Freeman date 10/21/97

Construction Authorization

HEALTH DEPT. COPY: WHITE INSPECTION COPY (FINAL): GREEN OWNER COPY (FINAL): YELLOW INSPECTION COPY (INITIAL): PINK OWNER COPY (INITIAL): GOLD