(3130)

IREDELL COUNTY HEALTH DEPARTMENT Const Auth. STATESVILLE 704-878-5305 MOORESVILLE 704-664-5281

IMPROVEMENT PERMIT / ~~CERTIFICATE OF COMPLETION~~ / OPERATION PERMIT / EXISTING SYSTEM INSPECTION

PROPERTY DESCRIPTION NO. 24631 DATE April 28, '97 TAX MAP NO. parcel ICAS Watershed: ☑ Yes ☐ No

OWNER OR CONTRACTOR Krom Financial Services PHONE: Business ~~Home~~ 658-11-3233

ADDRESS 149 Yacht Cove Rd, Mooresville

LOCATION I-21N. TL Valley View TR Lismark on Right

SUBDIVISION Catawba BLOCK / SECTION LOT 52 LOT AREA 1.09Ac SITE CLASS PS DESIGN FLOW 360gpd L.T.A.R. .13

Septic Tank: Gallons; STB 525 Date 11/21/97
Pump Tank: Gallons; PT Date
Pump Make: Model Serial No.
Nitrification Field: No Fields 1 Square Feet 1200 Linear Feet 400
No Lines 5@80' Trench Width 36" Max Trench Bottom Depth 18" Gravel Depth 12"

☑ New System ☐ Repair System Type: I, II, III, IV, V, VI
System Description: Shallow pump conventional
Repair System Description: Scarp
Maintenance Agreement Required: ☐ Yes ☑ No

☑ House/Mod. Home No. Bedrooms 3
☐ Mobile Home No. Bathrooms 2
☐ Business No. Employees
☐ Other
☑ Slab ☐ Crawl Space ☐ Basement w/plumbing ☐ Basement wo/plumbing


Water Supply:
☑ Individual
☐ Community
☐ Public

Comments: Well

Comments: UPPER LINE SHUT OFF BY WELL DISCHARGE. = LINE WAS PUMPED OUT

1" = 100'

INITIAL SITE SKETCH

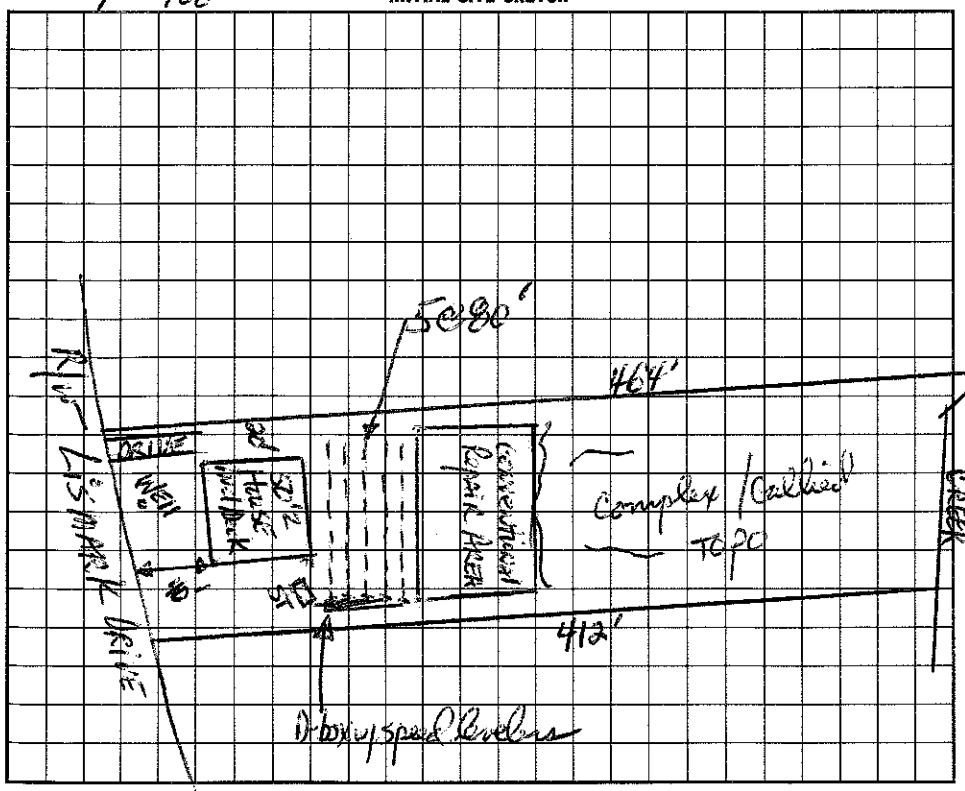

AS BUILT SKETCH

I understand that this permit can be suspended or revoked if any false information is supplied toward securing the permit/any unauthorized changes are made to the site/any unauthorized changes are made in the installation of the system. Improvement Permit is valid for 60 months from date of issuance.

Signed: *

Improvement Permit by: D.R. Hanson, RS date 4/28/97

~~Existing System Inspection by:~~ Construction Authorization D.R. Hanson, RS date 4/28/97

Installed by: ROWAN SEPTIC

Certificate of Completion by: date

Operation Permit by: C. Rg date 4/22/98

HEALTH DEPT. COPY: WHITE INSPECTION COPY (FINAL): GREEN OWNER COPY (FINAL): YELLOW INSPECTION COPY (INITIAL): PINK OWNER COPY (INITIAL): GOLD