IREDELL COUNTY HEALTH DEPARTMENT

Const. Auth. STATESVILLE 704-878-5305 MOORESVILLE 704-664-5281

IMPROVEMENT PERMIT / ~~CERTIFICATE OF COMPLETION~~ / OPERATION PERMIT / EXISTING SYSTEM INSPECTION

PROPERTY DESCRIPTION NO. 24628 DATE Aug 15, '97 TAX MAP NO. part of 1LA5 Watershed: ☑ Yes ☐ No

OWNER OR CONTRACTOR Krom Financial Services PHONE: Business 664-3671 ~~Home~~ 4658-11-3679 WSIV CA

ADDRESS 149 Yacht Cove Rd, Mooresville

LOCATION 21 N. TL Valleymar TR Lismark on Right at Cul-d-Sac

SUBDIVISION Oakbrook BLOCK / SECTION _____ LOT 49 LOT AREA 2.4AC SITE CLASS. RS DESIGN FLOW 360gpd L.T.A.R. .3

Septic Tank: 1000 Gallons; STB 825 Date 8/10/97

Pump Tank: _____ Gallons; PT _____ Date _____

Pump Make: _____ Model _____ Serial No. _____

Nitrification Field: No Fields 1 Square Feet 1200 Linear Feet 400

No Lines 3 @ 133 Trench Width 36" Max Trench Bottom Depth 18" Gravel Depth 12"

☑ New System ☐ Repair System Type: I, II, III, IV, V, VI

System Description: gravity conventional

Repair System Description: gravity pumped conventional

Maintenance Agreement Required: ☐ Yes ☑ No

☑ House/Mod. Home No. Bedrooms 3

☐ Mobile Home No. Bathrooms 2

☐ Business No. Employees ____

☐ Other _____

☐ Slab ☑ Crawl Space ☐ Basement w/plumbing ☐ Basement wo/plumbing


Water Supply: ☑ Individual ☐ Community ☐ Public

Comments: USE D-box w/speed levelers OR 3 Flow Dividers


Comments:

1" = 100'

INITIAL SITE SKETCH

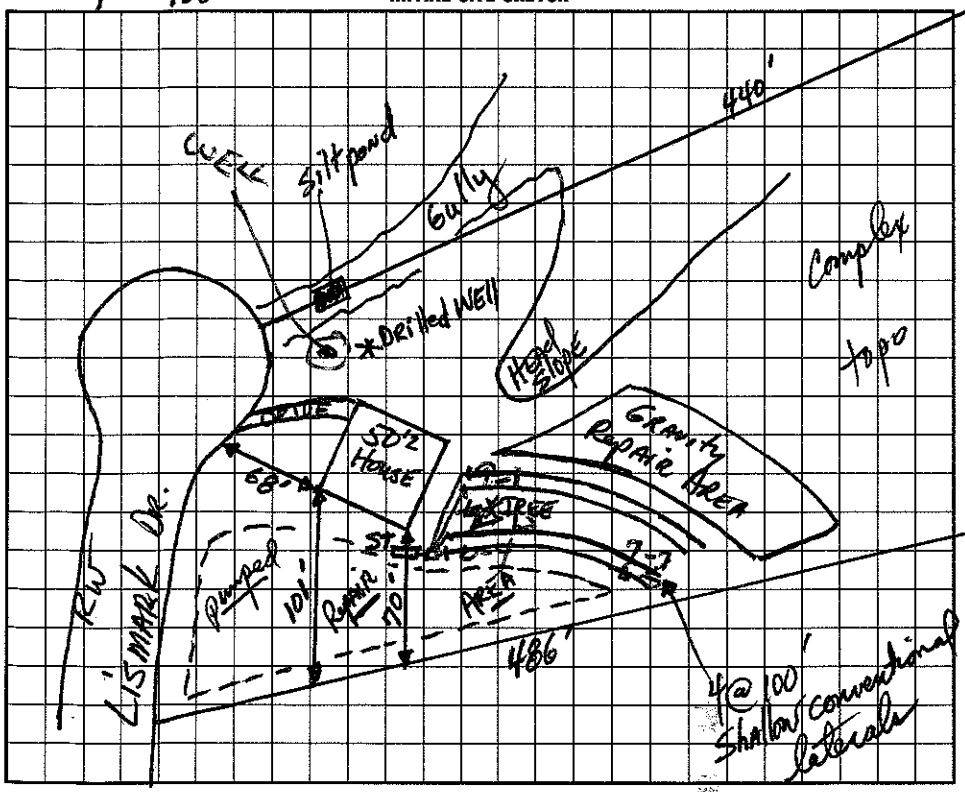

AS BUILT SKETCH

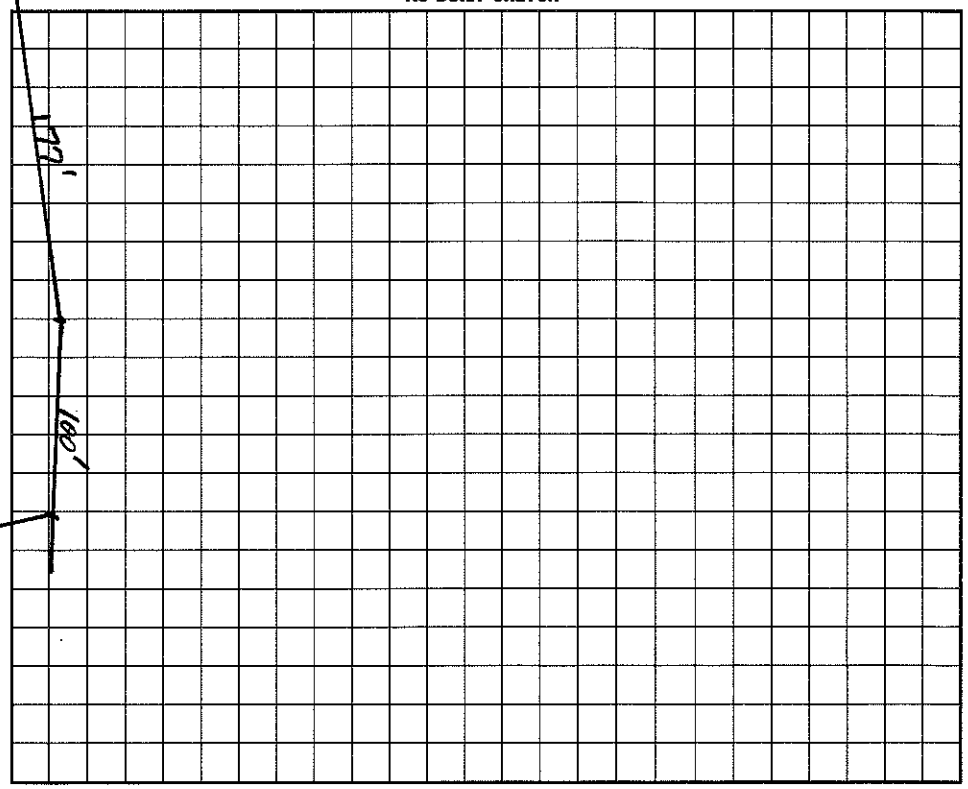

I understand that this permit can be suspended or revoked if any false information is supplied toward securing the permit/any unauthorized changes are made to the site/any unauthorized changes are made in the installation of the system. Improvement Permit is valid for 60 months from date of issuance.

Signed: _____

Improvement Permit by: _____ date 8-15-97

Construction ~~Existing System Inspection~~ by: _____ date 8-15-97

Authorization

Installed by: Rowen Septic Tank

Certificate of Completion by: Wesley Sparks R.S. date 9/23/97

Operation Permit by: Wesley Sparks R.S. date 9/23/97

HEALTH DEPT. COPY: WHITE INSPECTION COPY (FINAL): GREEN OWNER COPY (FINAL): YELLOW INSPECTION COPY (INITIAL): PINK OWNER COPY (INITIAL): GOLD