RECEIVED APR 2 9 '15

IREDELL COUNTY HEALTH DEPARTMENT


ENVIRONMENTAL HEALTH DIVISION

PAGE 2: *SITE PLAN WORKSHEET*

SEE THE "SAMPLE SITE PLAN" BELOW. *INCOMPLETE SITE PLANS WILL BE RETURNED TO YOU FOR COMPLETION AND MAY RESULT IN A DELAY IN THE ISSUANCE OF YOUR SEPTIC SYSTEM PERMIT*!!!

Place an (X) beside each item as you complete the site plan:

( ) Property Line measurements are clearly identified
( ) All proposed structures are indicated
( ) Front and side setbacks from property line
( ) Preferred driveway location and well location
( ) Area you prefer your septic system to be placed
( ) North arrow, or other sufficient indicator of direction

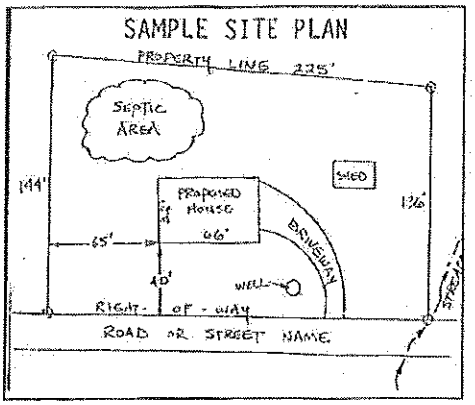


Circle N/A on the following if appropriate:

Location of septic systems and wells within 100' of your property	N/A
Location of easements and rights of ways on your property	N/A
Location of any designated wetlands on the property	N/A

USE THIS SPACE TO DRAW YOUR SITE PLAN

Show: proposed house or business footprint, wells, water lines, patios, pools and decks, and any other item that will occupy space on the site

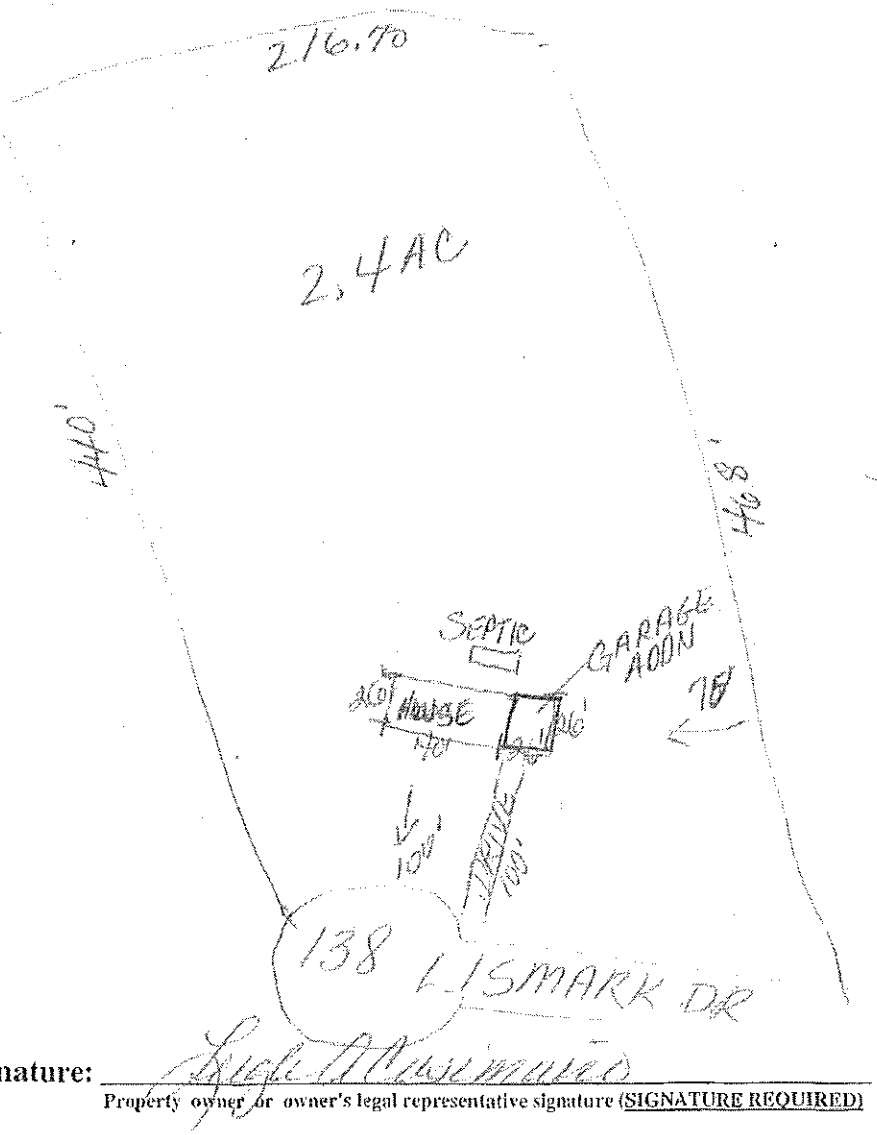

Signature: Leigh Ann Simmons

Property owner or owner's legal representative signature (SIGNATURE REQUIRED)

4/22/15

DATE

IREDELL COUNTY HEALTH DEPARTMENT Const. Auth. STATESVILLE 704-878-5305 MOORESVILLE 704-664-5281

IMPROVEMENT PERMIT / ~~CERTIFICATE OF COMPLETION~~ / OPERATION PERMIT / EXISTING SYSTEM INSPECTION

PROPERTY DESCRIPTION NO. 24628 DATE Aug 15, '97 TAX MAP NO. part of 11A5 Watershed: ☑ Yes ☐ No

OWNER OR CONTRACTOR Krom Financial Services PHONE: Business 664-3671 ~~Home~~ 658-11-3679 WSIV CA

ADDRESS 149 Yacht Cove Rd, Mooresville

LOCATION 21 N. TR Valleyview TR Lismark on Right at cul-d-sac

SUBDIVISION Oakbrook BLOCK / SECTION LOT 49 LOT AREA 2.7AC SITE CLASS. RS DESIGN FLOW 360gpd L.T.A.R. .3

Septic Tank: 1000 Gallons; STB 825 Date 8/10/97

Pump Tank: Gallons; PT Date

Pump Make: Model Serial No.

Nitrification Field: No Fields 1 Square Feet 1200 Linear Feet 400

No Lines 3 @ 165 Trench Width 36" Max Trench Bottom Depth 18" Gravel Depth 12"

☑ New System ☐ Repair System Type: I, II, III, IV, V, VI

System Description: gravity conventional

Repair System Description: ~~gravity~~ pumped conventional

Maintenance Agreement Required: ☐ Yes ☑ No

☑ House/Mod. Home No. Bedrooms 3

☐ Mobile Home No. Bathrooms 2

☐ Business No. Employees

☐ Other


☐ Slab ☑ Crawl Space ☐ Basement w/plumbing ☐ Basement wo/plumbing

Water Supply: ☑ Individual ☐ Community ☐ Public

Comments: USE D-box w/speed levelers OR 3 Flow Diverters
34ft btw House & well
House 30ft in depth includes porch
Deck 10ft deep x 37ft wide includes steps


INITIAL SITE SKETCH

1" = 100'

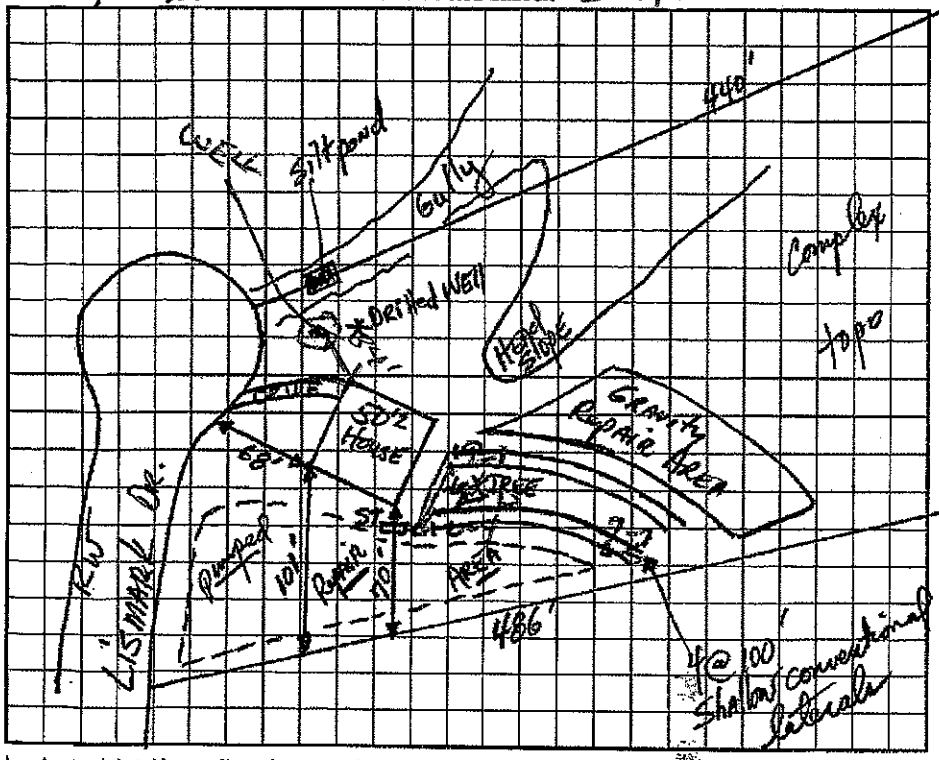

Comments: ST at edge of steps
10ft from House lines up with edge of House
House 40ft long

AS BUILT SKETCH

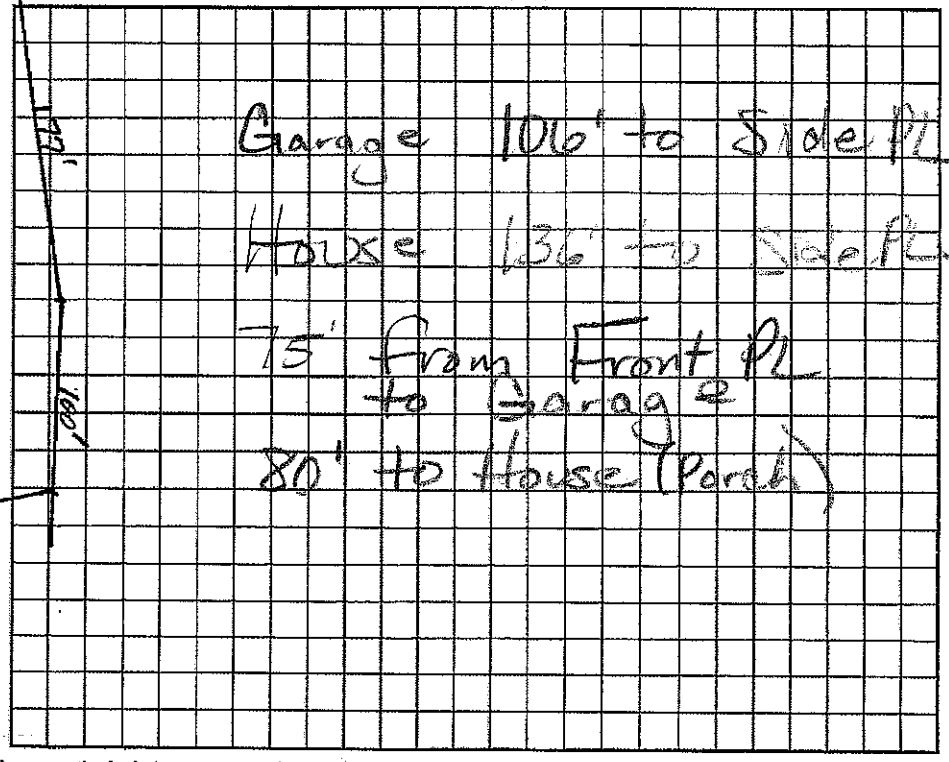

I understand that this permit can be suspended or revoked if any false information is supplied toward securing the permit/any unauthorized changes are made to the site/any unauthorized changes are made in the installation of the system. Improvement Permit is valid for 60 months from date of issuance.

Signed: [signature]

Improvement Permit by: D Hinson, RS date 8-15-97

~~Existing System Inspection~~ Construction Authorization by: D Hinson, RS date 8-15-97

Installed by: Rowan Septic Tank

Certificate of Completion by: Wesley Sparks R.S. date 9/23/97

Operation Permit by: Wesley Sparks R.S. date 9/23/97

HEALTH DEPT. COPY: WHITE INSPECTION COPY (FINAL): GREEN OWNER COPY (FINAL): YELLOW INSPECTION COPY (INITIAL): PINK OWNER COPY (INITIAL): GOLD