IREDELL COUNTY HEALTH DEPARTMENT Const. Auth. STATESVILLE 704-878-5305 MOORESVILLE 704-664-5281

IMPROVEMENT PERMIT / ~~CERTIFICATE OF COMPLETION~~ / OPERATION PERMIT / EXISTING SYSTEM INSPECTION

PROPERTY DESCRIPTION NO. 24647 DATE April 29, 97 TAX MAP NO. part of 1LA5 4658116570 Watershed: ☑ Yes ☐ No

OWNER OR CONTRACTOR Kyam Financial Services PHONE: Business _____ Home _____

ADDRESS 149 Yacht Cove Rd. Mooresville

LOCATION 21 N. to L Valleyview Rd. TR Patrose Lane on left at end

SUBDIVISION Oakbrook BLOCK / SECTION _____ LOT 61 LOT AREA 1.01 AC SITE CLASS. PS DESIGN FLOW 360gpd L.T.A.R. .3

Septic Tank: 1000 Gallons; STB ~~700~~ 925 Date 12/7/98

Pump Tank: 1000 Gallons; PT 47 Date _____

Pump Make: _____ Model _____ Serial No. _____

Nitrification Field: No Fields 1 Square Feet 1200 Linear Feet 400

No Lines 3@133' Trench Width 36" Max Trench Bottom Depth (18") Gravel Depth 12"

☑ New System ☐ Repair System Type: I, II, (III), IV, V, VI

System Description: pm - shallow conventional

Repair System Description: Shallow Chambered (pumped)

Maintenance Agreement Required: ☐ Yes ☑ No

☑ House/Mod. Home No. Bedrooms 3

☐ Mobile Home No. Bathrooms 2

☐ Business No. Employees _____

☐ Other _____


☐ Slab ☑ Crawl Space ☐ Basement w/plumbing ☐ Basement wo/plumbing

Water Supply: ☑ Individual ☐ Community ☐ Public

Comments:

Comments:

INITIAL SITE SKETCH 1" = 100'

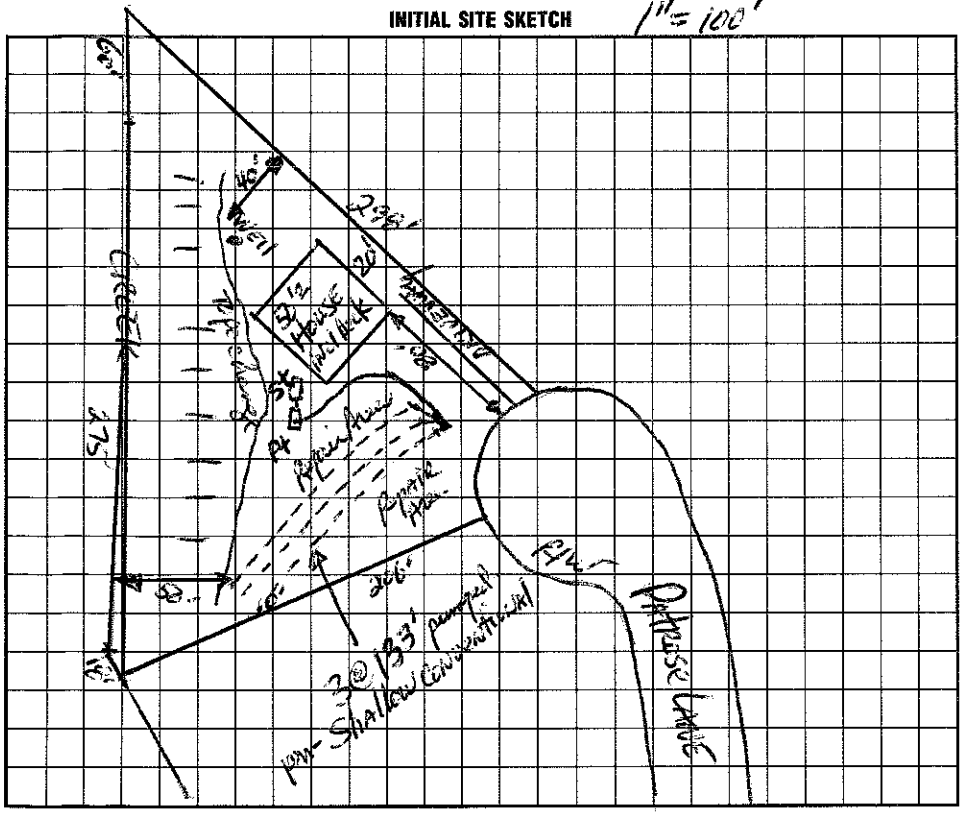

AS BUILT SKETCH

I understand that this permit can be suspended or revoked if any false information is supplied toward securing the permit/any unauthorized changes are made to the site/any unauthorized changes are made in the installation of the system. Improvement Permit is valid for 60 months from date of issuance.

Signed: * A Sanyi

Improvement Permit by: D K Thurman, RS date 4/29/97

~~Existing system inspection~~ Construction Authorization by: D K Thurman, RS date 4/29/97

Installed by: ROWAN SEPTIC

Certificate of Completion by: Wesley Sparks RS. date 3/9/98

Operation Permit by: Wesley Sparks RS. date 3/9/98

HEALTH DEPT. COPY: WHITE INSPECTION COPY (FINAL): GREEN OWNER COPY (FINAL): YELLOW INSPECTION COPY (INITIAL): PINK OWNER COPY (INITIAL): GOLD