IREDELL COUNTY HEALTH DEPARTMENT

Const. Auth

STATESVILLE 704-878-5305 MOORESVILLE 704-664-5281

IMPROVEMENT PERMIT / ~~CERTIFICATE OF COMPLETION~~ / OPERATION PERMIT / EXISTING SYSTEM INSPECTION

PROPERTY DESCRIPTION NO. 24637 DATE Oct. 13, '97 TAX MAP NO. part of 1LA5 4658 11 7009 Watershed: ☑ Yes ☐ No

OWNER OR CONTRACTOR Kaan Financial Services PHONE: Business 664-3671 Home USBCA

ADDRESS 149 Point Cove Rd Mooresville

LOCATION 121 N. TL Valleyview TR Patrose 2nd on left

SUBDIVISION Oakbrook BLOCK / SECTION LOT 58 LOT AREA .75 Ac SITE CLASS. RS DESIGN FLOW 360 gpd L.T.A.R. .3

Septic Tank: 1000 Gallons; STB 825 Date 9/15/98

Pump Tank: 1000 Gallons; PT 47 Date 9/14/98

Pump Make: ZOELLER Model N-983 Serial No. 9/15/98

Nitrification Field: No Fields 1 Square Feet 1200 Linear Feet 400

No Lines 4@100 Trench Width 36" Max Trench Bottom Depth 24" Gravel Depth 12"

☑ New System ☐ Repair System Type: I, II, III, IV, V, VI

System Description: pumped-pm- conventional

Repair System Description: same

Maintenance Agreement Required: ☐ Yes ☑ No

☑ House/Mod. Home No. Bedrooms 3

☐ Mobile Home No. Bathrooms 2

☐ Business No. Employees

☐ Other

☐ Slab ☑ Crawl Space ☐ Basement w/plumbing ☐ Basement wo/plumbing


Water Supply: ☑ Individual ☐ Community ☐ Public

Comments:


Comments: 5@80' X3'

1"=100'

INITIAL SITE SKETCH

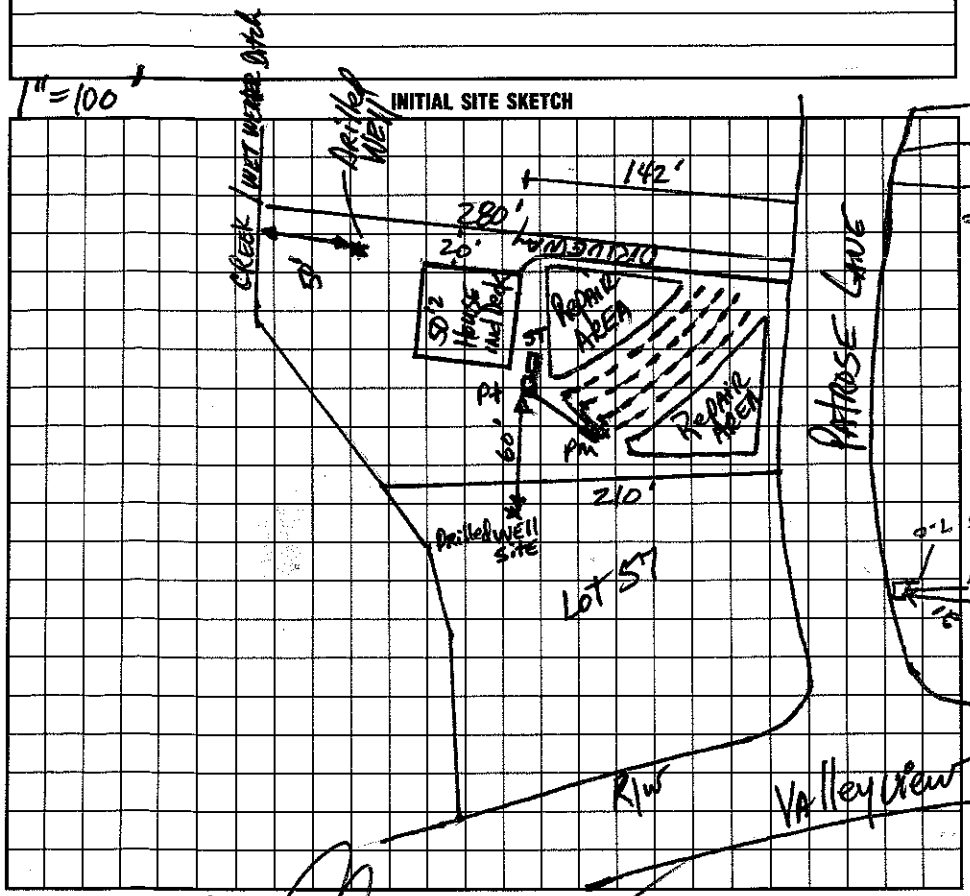

AS BUILT SKETCH

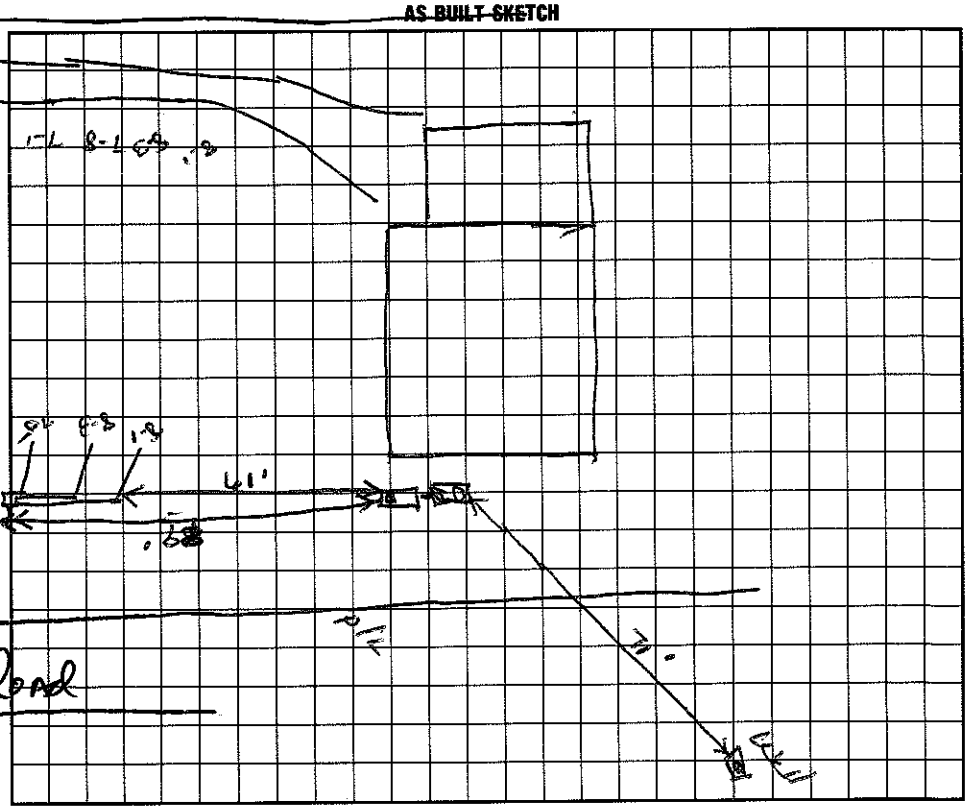

I understand that this permit can be suspended or revoked if any false information is supplied toward securing the permit/any unauthorized changes are made to the site/any unauthorized changes are made in the installation of the system. Improvement Permit is valid for 60 months from date of issuance.

Signed:

Improvement Permit by: [signature] RS date 10-13-97

~~Existing System Inspection by:~~ Construction Authorization [signature] RS date 10-13-97

Installed by: Rowan Septic

Certificate of Completion by: [signature] RS date 11/24/98

Operation Permit by: [signature] RS date 11/24/98

HEALTH DEPT. COPY: WHITE INSPECTION COPY (FINAL): GREEN OWNER COPY (FINAL): YELLOW INSPECTION COPY (INITIAL): PINK OWNER COPY (INITIAL): GOLD