(3:30)

IREDELL COUNTY HEALTH DEPARTMENT Const. Auth. STATESVILLE 704-878-5305 MOORESVILLE 704-664-5281

IMPROVEMENT PERMIT / ~~CERTIFICATE OF COMPLETION~~ / OPERATION PERMIT / EXISTING SYSTEM INSPECTION

PROPERTY DESCRIPTION NO. 24638 DATE Jan 30, '97 TAX MAP NO. part of 7LA5 Watershed: ☑ Yes ☐ No

OWNER OR CONTRACTOR Ivory Financial Services PHONE: Business 4658 11 7212 Home

ADDRESS 144 Yacht Cove Rd Mooresville

LOCATION US 21 N TL Valleyview TR Potrose on left near end

SUBDIVISION Oakbrook BLOCK / SECTION LOT 59 LOT AREA ± .8 Ac SITE CLASS. PS DESIGN FLOW 360 gpd L.T.A.R. ± .3

Septic Tank: 1000 Gallons; STB 825 Date 9/17/97

Pump Tank: 1000 Gallons; PT 417 Date 9/17/97

Pump Make: ZOELLER Model N137C Serial No. 1370002

Nitrification Field: No. Fields 1 Square Feet 1200 Linear Feet 400

No. Lines 4@100' Trench Width 36" Max Trench Bottom Depth 24" Gravel Depth 12"

☑ New System ☐ Repair System Type: I, II, III, IV, V, VI

System Description: pumped conventional

Repair System Description: same

Maintenance Agreement Required: ☐ Yes ☑ No

☑ House/Mod. Home No. Bedrooms 3

☐ Mobile Home No. Bathrooms 2

☐ Business No. Employees

☐ Other

☐ Slab ☑ Crawl Space ☐ Basement w/plumbing ☐ Basement wo/plumbing


Water Supply: ☑ Individual ☐ Community ☐ Public

Comments:

Comments: LINES, TANKS CHECKED

1"=50'

INITIAL SITE SKETCH

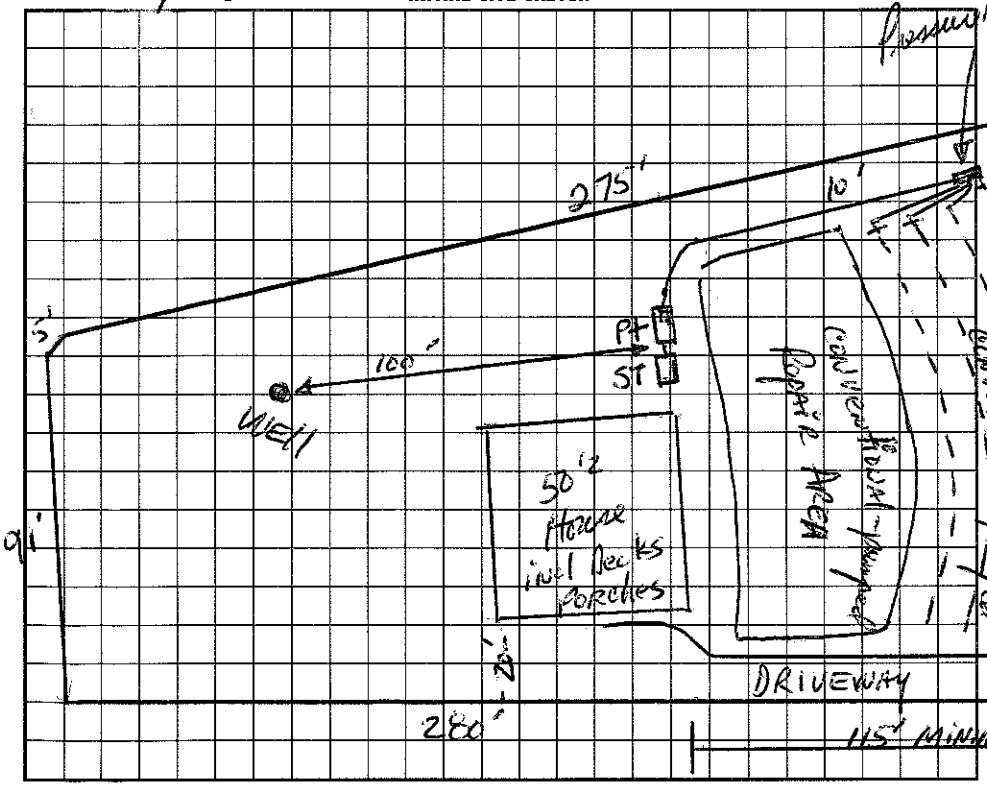

AS BUILT SKETCH

I understand that this permit can be suspended or revoked if any false information is supplied toward securing the permit/any unauthorized changes are made to the site/any unauthorized changes are made in the installation of the system. Improvement Permit is valid for 60 months from date of issuance.

Signed:

Improvement Permit by: date 1-30-97

~~Existing System Inspection by:~~ Construction Authorization date 1-30-97

Installed by: ROWAN SEPTIC

Certificate of Completion by: Wesley Sparks RS. date 11/24/97

Operation Permit by: Wesley Sparks RS. date 11/24/97

HEALTH DEPT. COPY: WHITE INSPECTION COPY (FINAL): GREEN OWNER COPY (FINAL): YELLOW INSPECTION COPY (INITIAL): PINK OWNER COPY (INITIAL): GOLD