75315 4:00

IREDELL COUNTY HEALTH DEPARTMENT Const. Auth

STATESVILLE 704-878-5305 MOORESVILLE 704-664-5281

IMPROVEMENT PERMIT / ~~CERTIFICATE OF COMPLETION~~ / OPERATION PERMIT / EXISTING SYSTEM INSPECTION

PROPERTY DESCRIPTION NO. 24639 DATE Oct 13, '97 TAX MAP NO. part of 1LA5 4658 11 7324 Watershed: ☑ Yes ☐ No

OWNER OR CONTRACTOR Kayon Financial Services PHONE: Business 664-3671 Home

ADDRESS 149 Yacht Cove Rd. Mooresville NC

LOCATION 21N. TL Valleyview TR PATROSE on left at End

SUBDIVISION Oakbrook BLOCK / SECTION LOT 60 LOT AREA .67Ac SITE CLASS. PS DESIGN FLOW 360gpd L.T.A.R. .3

Septic Tank: 1000 Gallons; STB 825 Date 10/17/97

Pump Tank: 1000 Gallons; PT 47 Date 12/30/98

Pump Make: Model Serial No.

Nitrification Field: No Fields 1 Square Feet 1200 Linear Feet 400

No Lines 4@100' Trench Width 36" Max Trench Bottom Depth 18" Gravel Depth 12"

☑ New System ☐ Repair System Type: I, II, (III), IV, V, VI

System Description: pumped-pm- Conventional

Repair System Description: Same

Maintenance Agreement Required: ☐ Yes ☑ No

☑ House/Mod. Home No. Bedrooms 3

☐ Mobile Home No. Bathrooms 2

☐ Business No. Employees

☐ Other

☐ Slab ☑ Crawl Space ☐ Basement w/plumbing ☐ Basement wo/plumbing


Water Supply: ☑ Individual ☐ Community ☐ Public

Comments:

Comments:

1" = 100'

INITIAL SITE SKETCH

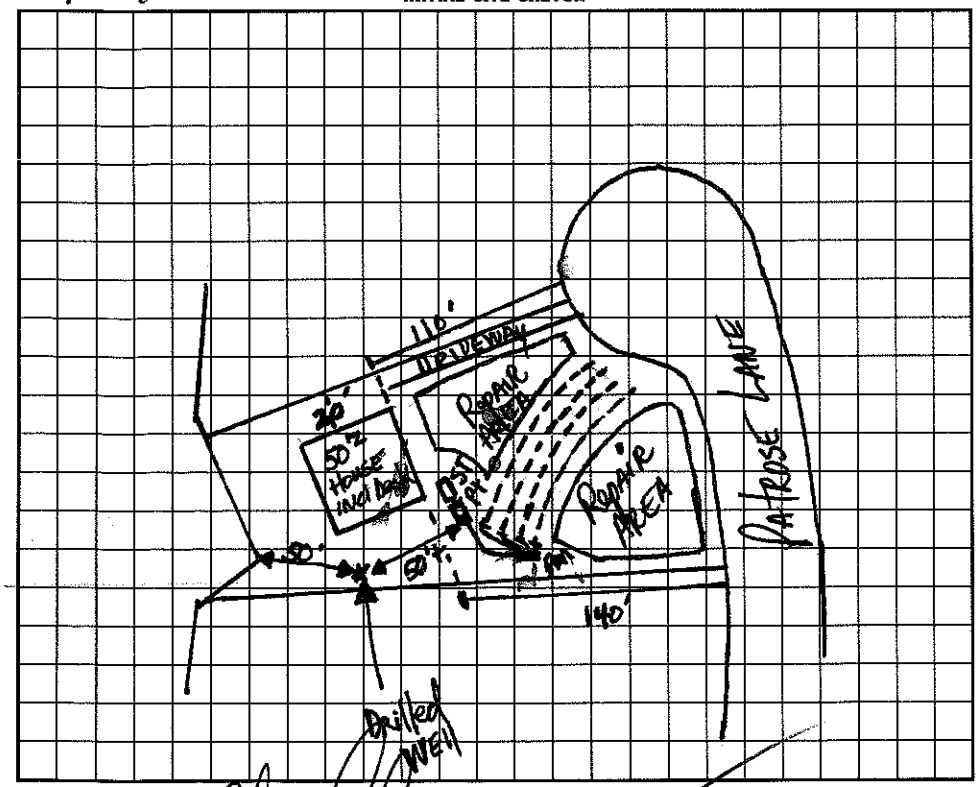

AS BUILT SKETCH

I understand that this permit can be suspended or revoked if any false information is supplied toward securing the permit/any unauthorized changes are made to the site/any unauthorized changes are made in the installation of the system. Improvement Permit is valid for 60 months from date of issuance.

Signed:

Improvement Permit by: DR Hinson RS date 10-13-97

~~Construction~~ ~~Existing System Inspection by:~~ DR Hinson RS date 10-13-97

Authorization

Installed by: Rowan Septic

Certificate of Completion by: Jeff Morgan date 11/25/98

Operation Permit by: date

HEALTH DEPT. COPY: WHITE INSPECTION COPY (FINAL): GREEN OWNER COPY (FINAL): YELLOW INSPECTION COPY (INITIAL): PINK OWNER COPY (INITIAL): GOLD