IREDELL COUNTY HEALTH DEPARTMENT

STATESVILLE 704-878-5305 MOORESVILLE 704-664-5281

IMPROVEMENT PERMIT / AUTHORIZATION TO CONSTRUCT / OPERATION PERMIT / EXISTING SYSTEM INSPECTION

PERMIT# 24642 PIN# part of 4658 11 9485 DATE 4/23/98

OWNER OR CONTRACTOR Krom Financial Services PHONE: ~~Mobile~~ ~~Business~~ 361-7518 Home

ADDRESS 149 Yacht Cove Rd. Mooresville, NC

LOCATION 21 N TL Valleyview TR Patrose at End on right

SUBDIVISION Oakbrook BLOCK SECTION LOT 63 LOT AREA 1.86Acre SITE CLASS. PS DESIGN FLOW 360gpd L.T.A.R. .3

Septic Tank: 1000 Gallons; STB 825 Date 3/1/98

Pump Tank: 1000 Gallons; PT 47 Date 4/5/98

Pump Make: ZOELLER Model N-137C Serial No. 3/5/98

Nitrification Field: No Fields 1 Square Feet 1200 Linear Feet 400

No Lines 4 at 100' Trench Width 36" Max Trench Bottom Depth 18"-24" Gravel Depth 12"

☒ New System ☐ Repair System Type: I, II, (III), IV, V, VI

System Description: Pumped-pm-Conventional

Repair System Description: pm-Chambered

Maintenance Agreement Required: ☐ Yes ☒ No

☒ House/Mod. Home No. Bedrooms 3

☐ Mobile Home No. Bathrooms 2

☐ Business No. Employees

☐ Other


☐ Slab ☒ Crawl Space ☐ Basement w/plumbing ☐ Basement wo/plumbing

Water Supply: ☒ Individual ☐ Public ☐ Community

Comments/Conditions: (Ductile Iron or Equivalent Sleeve under Drive) (PM) Pressure Manifold

Comments/Conditions:

INITIAL SITE SKETCH Scale 1"=100'

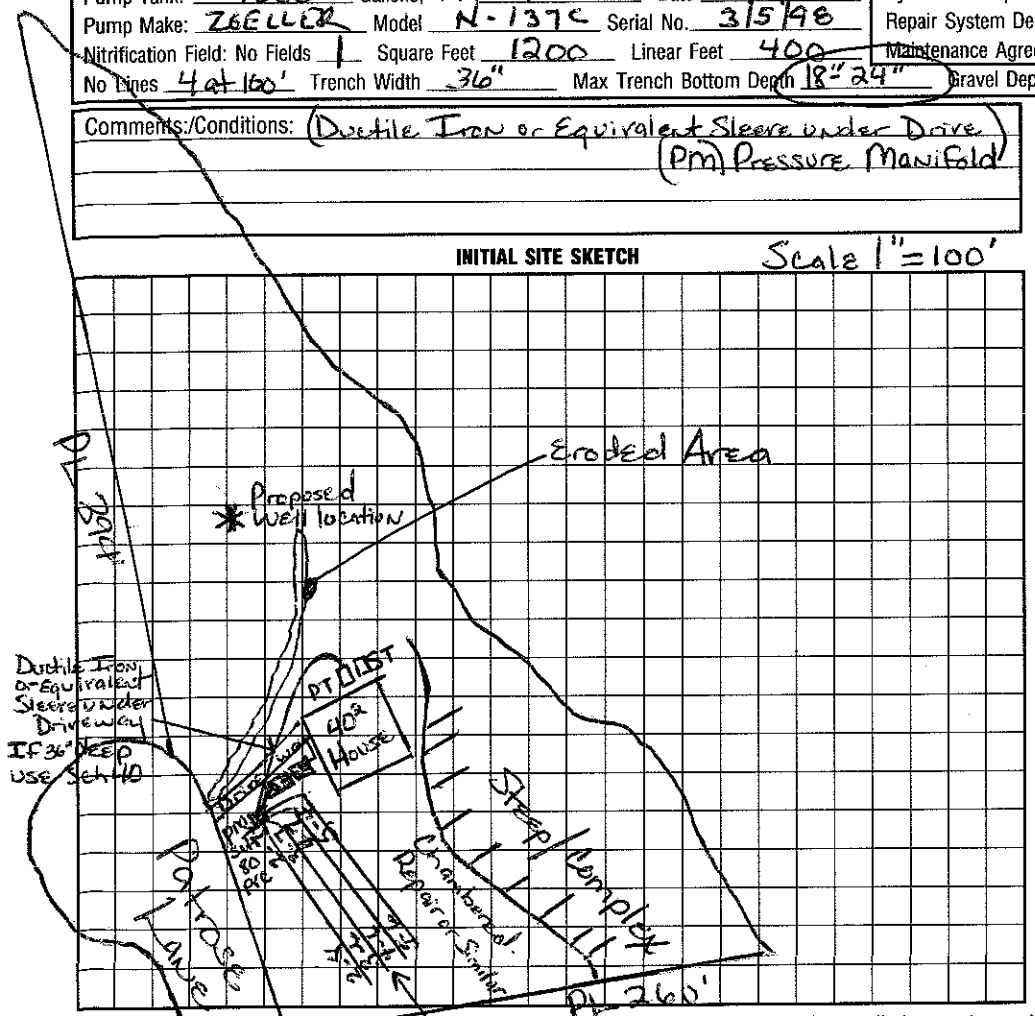

AS BUILT SKETCH

I understand that this permit can be suspended or revoked if any false information is supplied toward securing the permit/any unauthorized changes are made to the site/any unauthorized changes are made in the installation of the system. Improvement Permit with plat valid without expiration. Improvement Permit with site plan valid for sixty months. Authorization to Construct is valid for a period equal to that of Improvement Permit – not to exceed sixty months.

4 lines at 100' conventional

Signed: [signature] date 4/30/98 Installed by: Rowan Septic Tank

Improvement Permit by: Maria H. Dotson date 4/23/98 Operation Permit by: Wesley Sparks RS. date 4/26/98

Authorization to Construct by: Maria H. Dotson date 4/23/98 Existing System Inspection by: date

HEALTH DEPT. COPY: WHITE INSPECTION COPY (FINAL): GREEN OWNER COPY (FINAL): YELLOW INSPECTION COPY (INITIAL): PINK OWNER COPY (INITIAL): GOLD