IREDELL COUNTY HEALTH DEPARTMENT

Statesville Office (704) 878-5305 Mooresville Office (704) 660-3625 PERMIT # 2100 AP 210466

IMPROVEMENT PERMIT / AUTHORIZATION TO CONSTRUCT / OPERATION PERMIT / EXISTING SYSTEM

PIN # 4658142371

APPLICANT: David Clubb APPLICANT ADDRESS: 303 Cornelius Rd Mooresville, NC

SITE ADDRESS: 303 Cornelius Rd Mooresville, NC PHONE: ALT. PHONE: 7046639441

SITE DIRECTIONS: Hwy 21 N TL Cornelius Rd on left

SUBDIVISION: SECTION: LOT # LOT AREA: 2 Acre DESIGN FLOW: 360gpd L.T.A.R.: .3

Septic Tank X 1000 (gal) STB 465 Date 4-7-15
Pump Tank (gal) PT Date
Pump Make Model Serial #
Nitrification Fields 3 # Lines Existing Linear Ft:
Trench Width Max. Trench Bottom Depth Drainfield Beds Gravel Depth

☐ New System ☒ Repair ☐ Expansion System Type: I II ☒ III IV V VI
System Description: New ST only
Repair System Description:
Maintenance Agreement Required: ☐ YES ☐ NO ☐ GRAVITY ☐ PRESSURE

☒ Residence ☐ Business ☐ Other ☐ Slab ☐ Basement w/plumbing
No. Bedrooms 3 No. Persons 6 No. Employees
☒ Crawl Space ☐ Basement w/o plumbing


Water Supply: ☒ Private ☐ Public ☐ Community

Existing

Comments / Conditions: X Must use "Traffic rate" Septic tank if Vehicular traffic goes over ST.

X Install new Septic tank in same location as Old ST
5/22/15 Installed new Distribution box & 2 speed levelers feeding equally

INITIAL SITE SKETCH

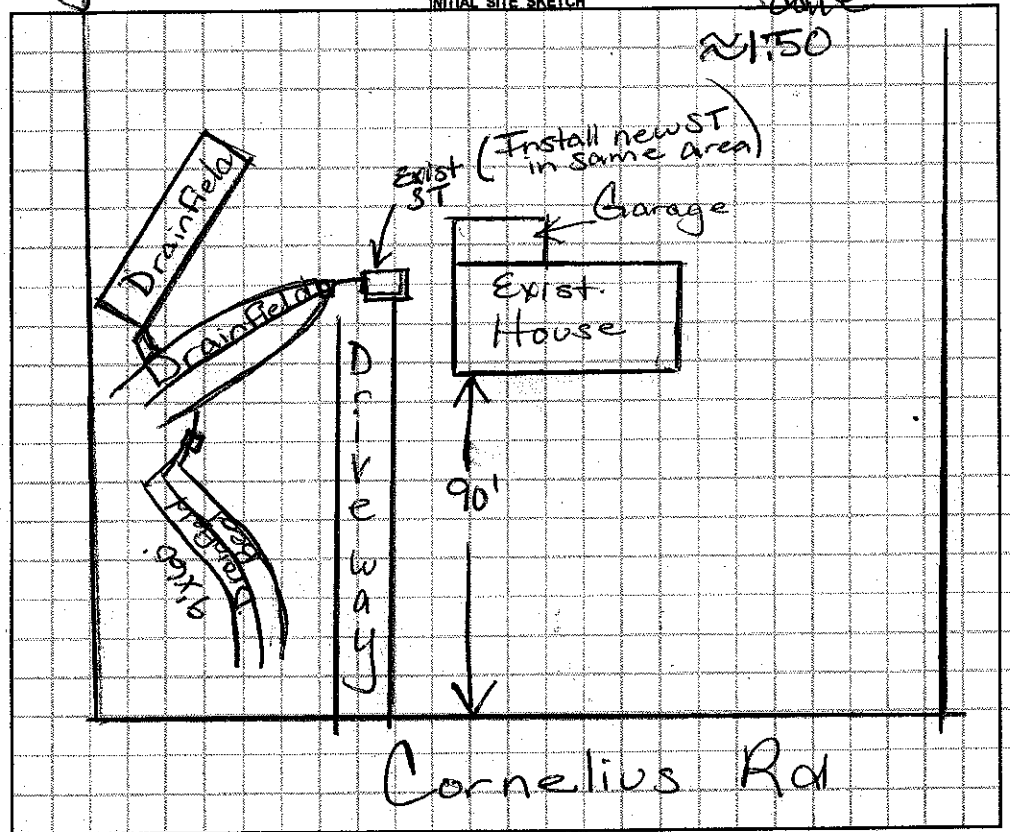

AS BUILT SKETCH

Permit can be suspended or revoked if any false information is supplied toward securing the permit / any unauthorized changes are made to the site / any unauthorized changes are made in the installation of the system. CONTACT A LOCATOR SERVICE PRIOR TO ANY EXCAVATION

☐ IMPROVEMENT PERMIT with plat valid without expiration. ☐ IMPROVEMENT PERMIT with site plan valid for 60 mos. ☐ AUTHORIZATION TO CONSTRUCT valid for period equal to IMPROVEMENT PERMIT--not to exceed 60 mo.

Owner / Applicant Signature: 5/20/15 Date: Installed by: Wayne Acbison

IMPROVEMENT PERMIT by: RS Date: 5/18/15 OPERATION PERMIT by: RS Date: 5/22/15

AUTHORIZATION TO CONSTRUCT by: RS Date: 5/18/15 Existing System Inspected by: Date:

Health Dept. Copy - WHITE Applicant (Final Approval) - YELLOW Applicant (Conditional Approval) - PINK