RECEIVED MAY 1 3 2015

Paid $150.00

#210466

IREDELL COUNTY HEALTH DEPARTMENT

ENVIRONMENTAL HEALTH DIVISION

PAGE 1: *APPLICATION FORM*

Application For: ( ) New Well Permit ( ) Well Repair Permit ( ) Well Abandonment
( ) Septic Improvement Permit ( ) Authorization to Construct ( ) Existing System Inspection (✓) Septic System Repair

THE ABOVE PERMIT DOCUMENTS WILL BECOME INVALID IF INFORMATION PROVIDED ON THIS APPLICATION IS FALSIFIED OR CHANGED, OR IF THE SITE IS ALTERED. THE IMPROVEMENT PERMIT IS VALID FOR EITHER 60 MONTHS OR WITHOUT EXPIRATION DEPENDING UPON DOCUMENTATION SUBMITTED APPLICATION WITH SITE PLAN 60 MONTHS, APPLICATION WITH COMPLETE, SCALED PLAT WITHOUT EXPIRATION. SEE 15A NCAC 18A .1937(f) FOR DETAILS.

Page 2: *Site Plan Worksheet* form MUST accompany this application

The following optional attachments may also be submitted: ( ) Survey Plat, scaled no more than 1 inch = 60 feet
Place an (X) beside whichever is submitted if applicable ( ) Custom Site Plan, scaled no more than 1 inch = 60 feet

Applicant Information:

Applicant Name: DAVID Clubb **Address:** 303 CORNELIUS Rd **Phone:** 704-663-9441

Owner Name: SAME **Address:** AS ABOVE **Phone:** ~~~~

Property Information:

Street Address: 303 CORNELIUS Rd

Subdivision Name: NONE **Section/Phase:** ~~~~ **Lot Number:** ~~~~

Driving Directions:

Site Development Information: *(check or complete ALL that apply)*

(✓) New Single Family Residence
( ) New Multi-Family Residence
( ) Accessory Building
( ) Bedroom(s) Addition

Maximum Number of Bedrooms: 3
Maximum Number of Occupants: 2
(✓) Swimming Pool
( ) Other Addition/Structure:

( ) Crawl Space Foundation
(✓) Concrete Slab Foundation
( ) Basement with Plumbing
( ) Basement without Plumbing

Non-Residential Site Development:
Type of Business:
Square Footage of Building:
Maximum Number of Employee:
Maximum Number of Seats/Beds/Other:

Water Supply:

( ) New Well (✓) Existing Well ( ) Community Well ( ) City Water ( ) Other Public Water

Desired Septic System Type: *(you may rank in order of preference)* **Year existing system installed:**
( ) No Preference ( ) Alternative ( ) Conventional ( ) Innovative ( ) Modified Conventional ( ) Other:

Please answer the following to the best of your ability:
( ) Yes (✓) No Does the site contain any jurisdictional wetlands?
( ) Yes (✓) No Is any non-domestic sewage (i.e. industrial) to be generated?
( ) Yes (✓) No Is the site subject to approval by any other public agency?

I have read this application and certify that the information provided herein is true, complete, and correct. Authorized county and state officials are granted right of entry to conduct necessary inspections to determine compliance with applicable laws and rules. I understand that I am solely responsible for the proper identification and labeling of all property lines and corners and making the site accessible so that a complete site evaluation can be performed.

Signature: David Clubb
Property owner or owner's legal representative signature (SIGNATURE REQUIRED)

5/13/15
DATE

IREDELL COUNTY HEALTH DEPARTMENT


ENVIRONMENTAL HEALTH DIVISION

PAGE 2: ***SITE PLAN WORKSHEET***

SEE THE "SAMPLE SITE PLAN" BELOW. ***INCOMPLETE SITE PLANS WILL BE RETURNED TO YOU FOR COMPLETION AND MAY RESULT IN A DELAY IN THE ISSUANCE OF YOUR SEPTIC SYSTEM PERMIT!!!***

Place an (X) beside each item as you complete the site plan:

- ( ) **Property Line measurements are clearly identified**
- ( ) **All proposed structures are indicated**
- ( ) **Front and side setbacks from property line**
- ( ) **Preferred driveway location and well location**
- ( ) **Area you prefer your septic system to be placed**
- ( ) **North arrow, or other sufficient indicator of direction**

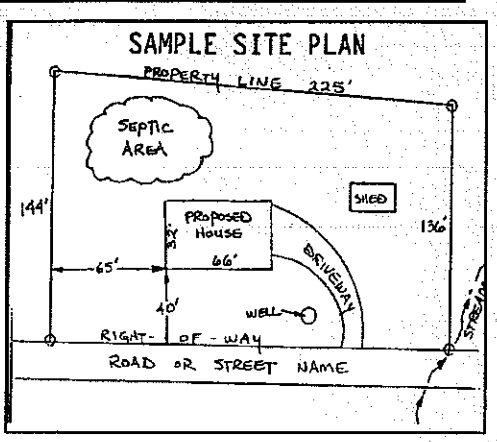


Circle N/A on the following if appropriate:

Location of septic systems and wells within 100' of your property	**N/A**
Location of easements and rights of ways on your property	**N/A**
Location of any designated wetlands on the property	**N/A**

USE THIS SPACE TO DRAW YOUR SITE PLAN

Show: proposed house or business footprint, wells, water lines, patios, pools and decks, and any other item that will occupy space on the site

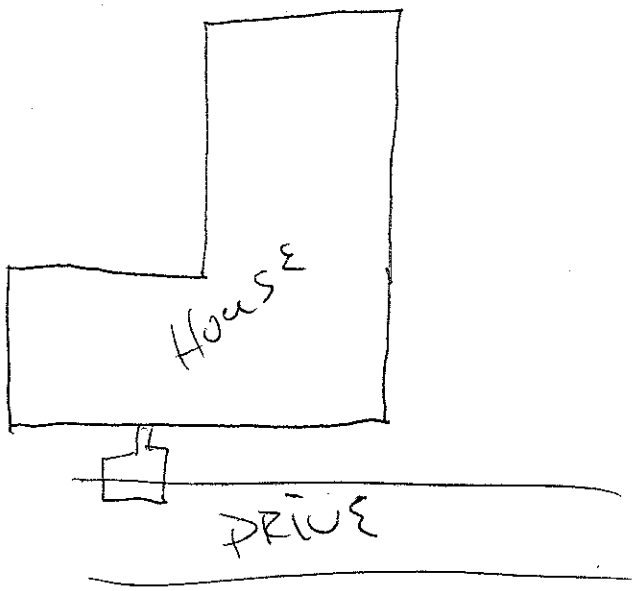

Signature: _____

Property owner or owner's legal representative signature (SIGNATURE REQUIRED)

5/13/15

DATE

Repair

IREDELL COUNTY HEALTH DEPARTMENT

STATESVILLE 704-878-5305 MOORESVILLE 704-664-5281

IMPROVEMENT PERMIT / AUTHORIZATION TO CONSTRUCT / OPERATION PERMIT / EXISTING SYSTEM INSPECTION

PERMIT# PIN# 4658142371 DATE 10/15/07

OWNER OR APPLICANT David Clubb PHONE: ~~Business~~ Home 704 663-9491 ~~Work~~ Home 704 202-9808

ADDRESS 303 Cornelius Rd. Mooresville NC 28115

LOCATION Hwy 21 N to Cornelius Rd. ± 2miles on Left 303 Cornelius Rd.

SUBDIVISION BLOCK / SECTION LOT LOT AREA ± 2ac SITE CLASS. PS DESIGN FLOW 360 L.T.A.R. e-3

Septic Tank Ex. 1000 Gallons: STB Date

Pump Tank: Gallons: PT Date

Pump Make: Model Serial No.

Nitrification Field: No Fields 1 Square Feet 540' Linear Feet 60'

No Lines 3 in a Bed Trench Width 9' Max Trench Bottom Depth 36" Gravel Depth Gravity ☐ Pressure

☐ New System ☑ Repair ☐ Expansion System Type: I (II) III IV V VI

System Description: 25% Reduction

Repair System Description: w/ a 9' x 60' Bed

Maintenance Agreement Required: ☐ Yes ☑ No

☑ House/Mod. Home No. Bedrooms 3

☐ Mobile Home No. Persons 4

☐ Business No. Employees

☐ Other


Water Supply: ☑ Individual ☐ Public ☐ Community

☐ Slab ☑ Crawl Space ☐ Basement w/plumbing ☐ Basement wo/plumbing

Comments/Conditions: Install 3 lines of a 25% Reduction System in 9' wide by 60' Bed, Connect to end of Exis drainfield using a DBox.

Comments/Conditions:

INITIAL SITE SKETCH

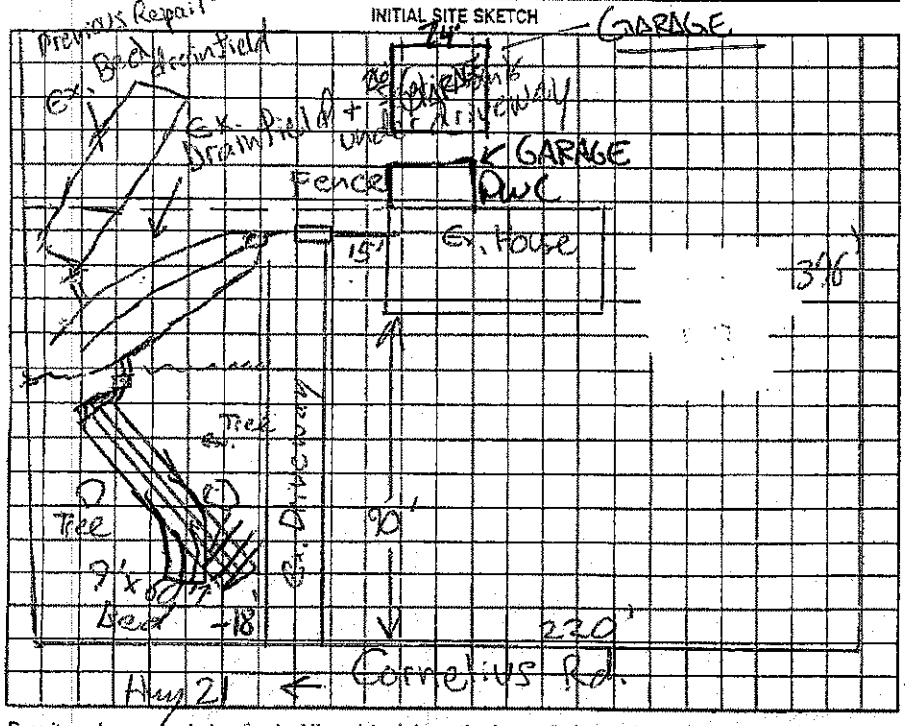

AS BUILT SKETCH

System installed as designed

11/5/07

The proposed / existing GARAGE addition does not appear to impact the existing septic system.

**NOTE:

R.S.

Date: 12-16-09

ICHD-Environmental Health Division

Location of the proposed DETACHED GARAGE addition does not appear to impact the existing on-site septic system.**NOTE:

REHS

Date: 10-13-11

ICHD-Environmental Health Division

Permit can be suspended or revoked if any false information is supplied toward securing the permit/any unauthorized changes are made to the site/any unauthorized changes are made in the installation of the system. Improvement Permit with plat valid without expiration ☑ Improvement Permit with site plan valid for sixty months ☑ Authorization to Construct is valid for a period equal to that of Improvement Permit – not to exceed sixty months.

Signed: date

Improvement Permit by: Anthony Cobos Jr. date 10/15/07

Authorization to Construct by: Anthony Cobos Jr. date 10/15/07


Operation Permit by: Anthony Cobos Jr. date 11/5/07

Existing System Inspection by: date

HEALTH DEPT. COPY: WHITE OWNER COPY (FINAL): YELLOW OWNER COPY (INITIAL): PINK