Repair

IREDELL COUNTY HEALTH DEPARTMENT

STATESVILLE 704-878-5305 MOORESVILLE 704-664-5281

IMPROVEMENT PERMIT / AUTHORIZATION TO CONSTRUCT / OPERATION PERMIT / EXISTING SYSTEM INSPECTION

PERMIT# PIN# 4658142371 DATE 10/15/07

OWNER OR APPLICANT David Clubb PHONE: ~~Home/Business~~ 704 663-9491 ~~Work/Home~~ 704 202-9808

ADDRESS 303 Cornelius Rd. Mooresville NC 28115

LOCATION Hwy 21 N to Cornelius Rd. ± 2miles on Left 303 Cornelius Rd.

SUBDIVISION _____ BLOCK / SECTION _____ LOT _____ LOT AREA ± 2ac. SITE CLASS. PS DESIGN FLOW 360 L.T.A.R. .03

Septic Tank Ex. 1000 Gallons: STB _____ Date _____

Pump Tank: _____ Gallons: PT _____ Date _____

Pump Make: _____ Model _____ Serial No. _____

Nitrification Field: No. Fields 1 Square Feet 540' Linear Feet 60'

No. Lines 3 in a Bed Trench Width 9' Max Trench Bottom Depth 26" Gravel Depth _____

☐ New System ☑ Repair ☐ Expansion System Type: I (II) III IV V VI

System Description: 25% Reduction

Repair System Description: w/ a 9' x 60' Bed

Maintenance Agreement Required: ☐ Yes ☑ No

☑ House/Mod. Home No. Bedrooms 3

☐ Mobile Home No. Persons 4

☐ Business No. Employees _____

☐ Other _____


Water Supply: ☑ Individual ☐ Public ☐ Community

☑ Gravity ☐ Pressure ☐ Slab ☑ Crawl Space ☐ Basement w/plumbing ☐ Basement wo/plumbing

Comments/Conditions: Install 3 lines of a 25% Reduction System in 9' wide by 60' Bed, connect to end of Exis drainfield using a DBox.

Comments/Conditions:

INITIAL SITE SKETCH

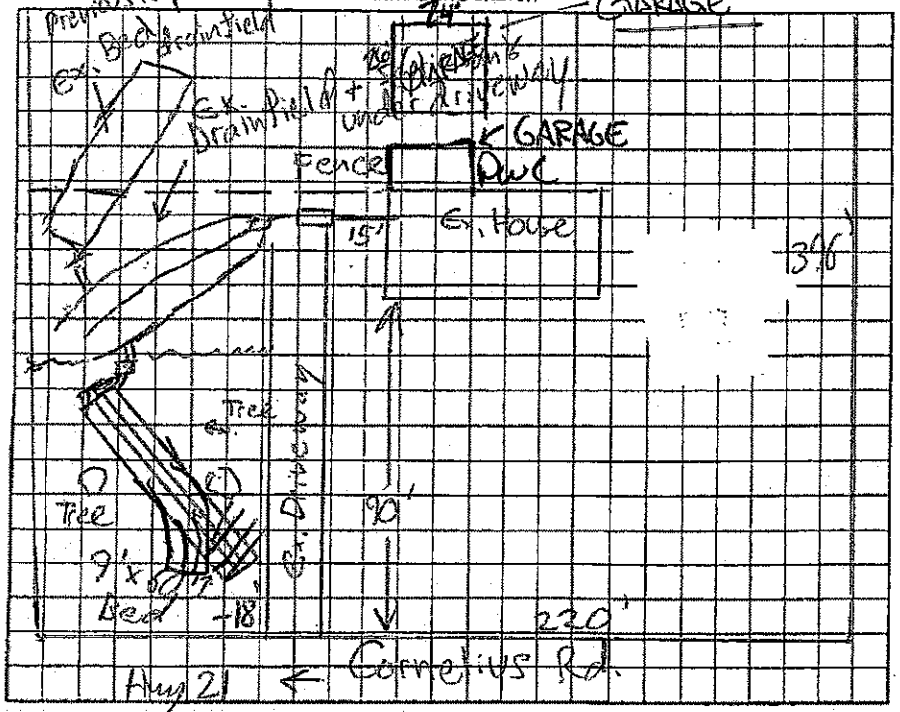

396'

AS BUILT SKETCH

System installed as designed

11/5/07

The proposed / existing GARAGE addition does not appear to impact the existing septic system.

**NOTE: _____ R.S.

Date: 12-16-09

ICHD-Environmental Health Division

Location of the proposed DETACHED GARAGE addition does not appear to impact the existing on-site septic system.**NOTE: _____ REHS

Date: 12-15-11

ICHD-Environmental Health Division

Permit can be suspended or revoked if any false information is supplied toward securing the permit/any unauthorized changes are made to the site/any unauthorized changes are made in the installation of the system. Improvement Permit with plat valid without expiration ☐ Improvement Permit with site plan valid for sixty months ☑ Authorization to Construct is valid for a period equal to that of Improvement Permit – not to exceed sixty months.

Signed: _____ date _____

Improvement Permit by: Anthony Cobos Jr. date 10/15/07

Authorization to Construct by: Anthony Cobos Jr. date 10/15/07


Operation Permit by: Anthony Cobos Jr. date 11/5/07

Existing System Inspection by: _____ date _____

HEALTH DEPT. COPY: WHITE OWNER COPY (FINAL): YELLOW OWNER COPY (INITIAL): PINK