IREDELL COUNTY HEALTH DEPARTMENT

STATESVILLE 704-878-5305 MOORESVILLE 704-664-5281

IMPROVEMENT PERMIT / AUTHORIZATION TO CONSTRUCT / OPERATION PERMIT / EXISTING SYSTEM INSPECTION

3:00

PERMIT# 093590 PIN# 4658 16 5521 Pt. 4658-16-7827

OWNER OR CONTRACTOR Jason A Cook PHONE: Business 872-7652 Home

ADDRESS 135 Big Forest Dr. Statesville, NC 28677 DATE 1/18/01

LOCATION 21N TL Bailey Rd. on R. past olive green double wide

SUBDIVISION No BLOCK / SECTION LOT LOT AREA 1.0 SITE CLASS. A5 DESIGN FLOW 360 L.T.A.R. .3

Septic Tank: 1000 Gallons; STB 825 Date 4/9/02

Pump Tank: Gallons; PT Date

Pump Make: Model Serial No.

Nitrification Field: No Fields 1 Square Feet 1200 Linear Feet 400

No Lines 4@100 Trench Width 3' Max Trench Bottom Depth 3' Gravel Depth 12"

☒ New System ☐ Repair System Type: I II III, IV, V, VI

System Description: GRAV - CONVENTIONAL

Repair System Description: PRESSURE - CONVENTIONAL

Maintenance Agreement Required: ☐ Yes ☐ No

☒ House/Mod. Home ☐ Mobile Home ☐ Business ☐ Other

No. Bedrooms 3 No. Bathrooms 2 No. Employees


☐ Slab ☒ Crawl Space ☐ Basement w/plumbing ☐ Basement wo/plumbing

Water Supply: ☒ Individual ☐ Public ☐ Community

Comments:/Conditions:

Comments:/Conditions:

INITIAL SITE SKETCH

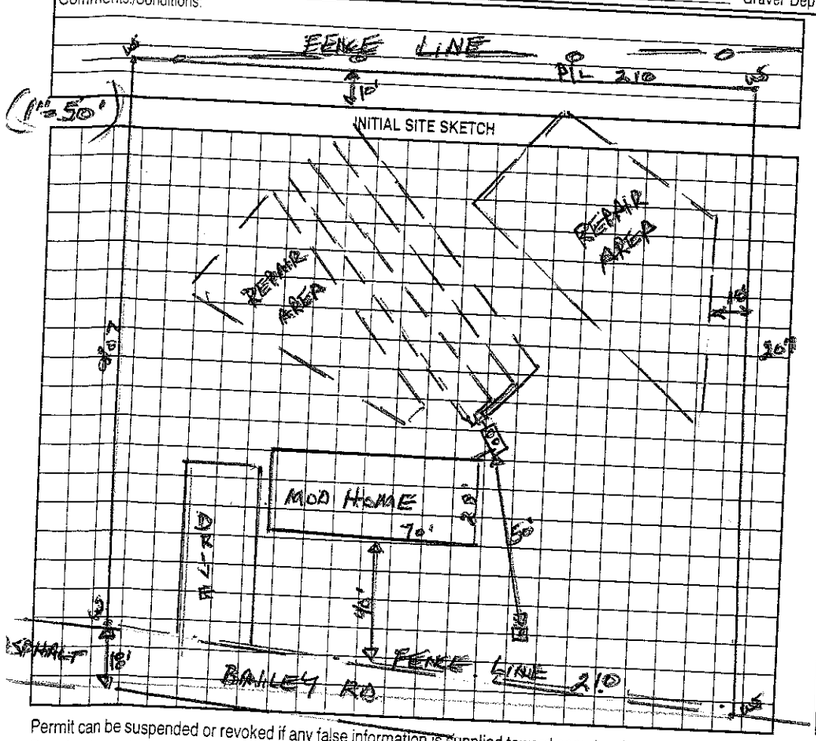

AS BUILT SKETCH

Permit can be suspended or revoked if any false information is supplied toward securing the permit/any unauthorized changes are made to the site/any unauthorized changes are made in the installation of the system. Improvement Permit with plat valid without expiration. Improvement Permit with site plan valid for sixty months. Authorization to Construct is valid for a period equal to that of Improvement Permit – not to exceed sixty months.

Signed: Jason A. Cook date

Improvement Permit by: Wesley Sparks RS. date 1/18/01

Authorization to Construct by: Wesley Sparks RS. date 1/18/01

Installed by: Rowan Septic

Operation Permit by: RS date 7/8/02

Existing System Inspection by: date

HEALTH DEPT. COPY: WHITE OWNER COPY (FINAL): YELLOW OWNER COPY (INITIAL): PINK