IREDELL COUNTY HEALTH DEPARTMENT

STATESVILLE 704-878-5305 130.00 Paid MOORESVILLE 704-664-5281 460

IMPROVEMENT PERMIT / AUTHORIZATION TO CONSTRUCT / OPERATION PERMIT / EXISTING SYSTEM INSPECTION

PERMIT# 118372 PIN# ~~4658-07-9720.000~~ 4658 17 0810 DATE 2/17/04

OWNER OR CONTRACTOR Cornelius Est LLC PHONE: Business 704-662-6677 Home

ADDRESS PO Box 927 Mooresville NC 28115

LOCATION Hwy 21 N, TL Cornelius, TR Olympia, TR Sparta on Rt Before Cul-de-Sac

SUBDIVISION Cornelius Est BLOCK / SECTION Lot 1 LOT ~~7~~ (1R) LOT AREA 0.704 Ac SITE CLASS PS DESIGN FLOW 480 L.T.A.R. 0.35

Septic Tank: 1000 Gallons; STB 794 Date 1-30-07

Pump Tank: Gallons; PT Date

Pump Make: Model Serial No.

Nitrification Field: No Fields 1 Square Feet 1035 Linear Feet 345

No Lines 3 Trench Width 36" Max Trench Bottom Depth 36" Gravel Depth —

☒ New System ☐ Repair System Type: I, II, (III), IV, V, VI

System Description: Gravity 25% Reduct.

Repair System Description: Pump Panel Block

Maintenance Agreement Required: ☐ Yes ☒ No

☒ House/Mod. Home No. Bedrooms 4

☐ Mobile Home No. Bathrooms 4

☐ Business No. Employees

☐ Other

☐ Slab ☒ Crawl Space ☐ Basement w/plumbing ☐ Basement wo/plumbing


Water Supply: ☒ Individual ☐ Public ☐ Community

Comments:/Conditions:


1" = 40'

Comments:/Conditions:

INITIAL SITE SKETCH

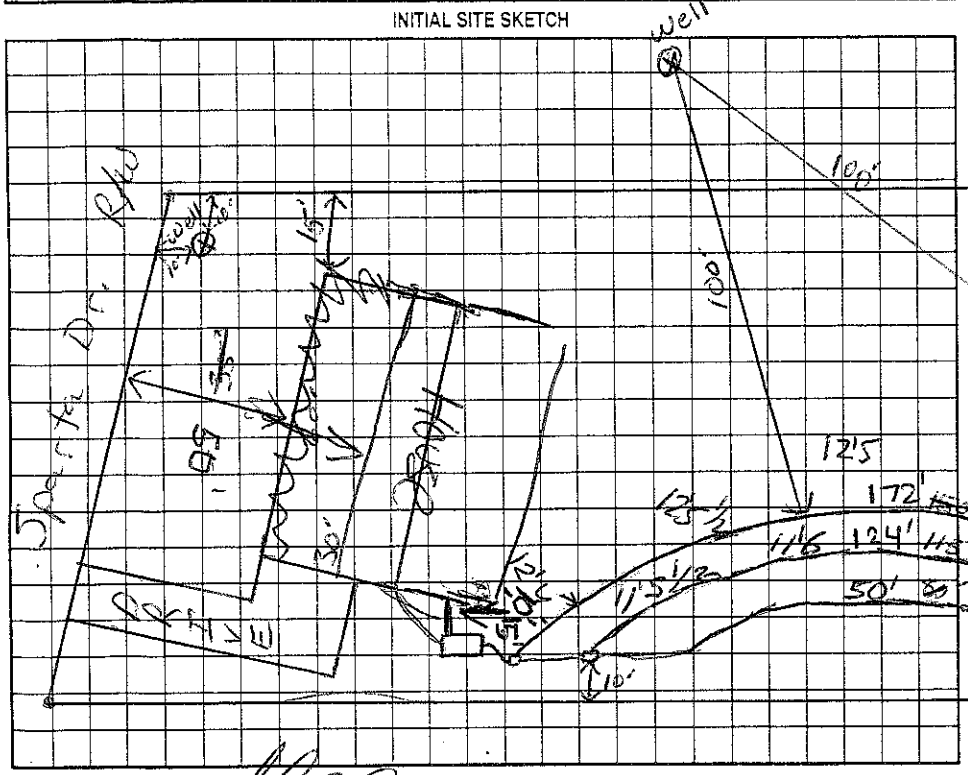

AS BUILT SKETCH

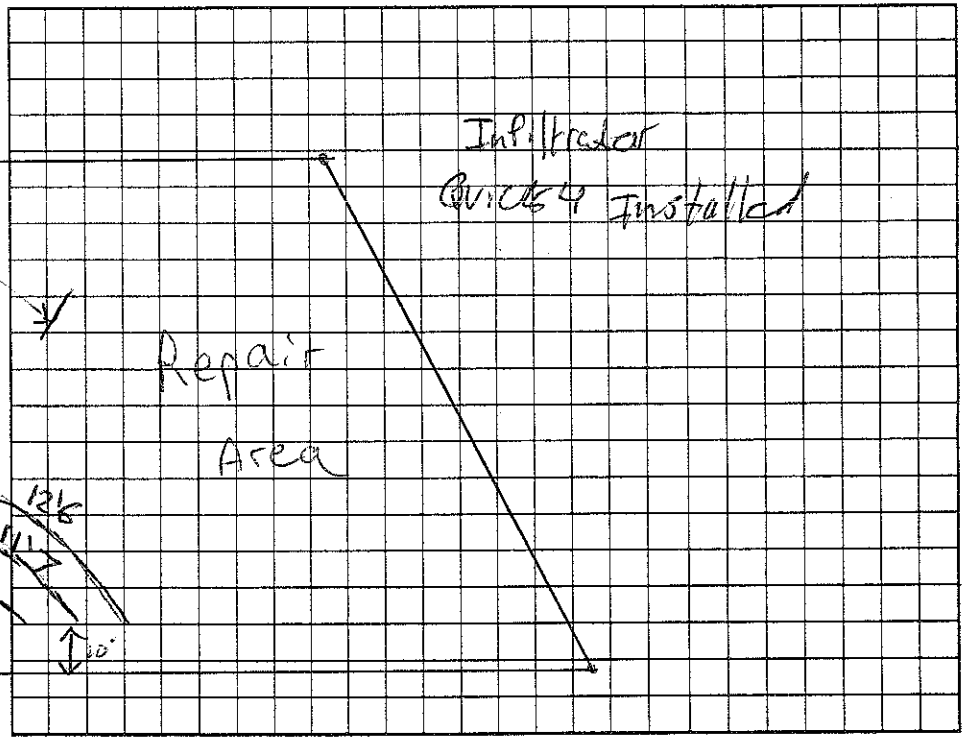

Permit can be suspended or revoked if any false information is supplied toward securing the permit/any unauthorized changes are made to the site/any unauthorized changes are made in the installation of the system. Improvement Permit with plat valid without expiration. Improvement Permit with site plan valid for sixty months. Authorization to Construct is valid for a period equal to that of Improvement Permit -- not to exceed sixty months.

Signed: _____ date 2-19-04 Installed by: Downing Construction

Improvement Permit by: _____ date 2/17/04 Operation Permit by: Anthony Colvard date 9/13/07

Authorization to Construct by: Wesley Sparks RS date 5/23/07 Existing System Inspection by: _____ date _____

HEALTH DEPT. COPY: WHITE OWNER COPY (FINAL): YELLOW OWNER COPY (INITIAL): PINK