IREDELL COUNTY HEALTH DEPARTMENT

Statesville Office (704) 878-5305 Mooresville Office (704) 660-3625 PERMIT # 216787

IMPROVEMENT PERMIT / AUTHORIZATION TO CONSTRUCT / OPERATION PERMIT / EXISTING SYSTEM

PIN # 4658171381

APPLICANT: Trevor Parker Johnson/Tyler Chris | APPLICANT ADDRESS: 378 Bailey Rd Mooresville, NC 28117

SITE ADDRESS: 378 Bailey Rd Mooresville NC | PHONE: 704 902 2721 | ALT. PHONE: 704 872 9918

SITE DIRECTIONS: Highway 21 N. TL Bailey Rd ~ 1 mile on right just past Warlick Dr.

SUBDIVISION: — | SECTION: — | LOT # — | LOT AREA: 3.41Ac | DESIGN FLOW: | L.T.A.R.:

EXIST

Septic Tank	1000 (gal)	STB	Date		
Pump Tank	(gal)	PT	Date		
Pump Make		Model	Serial #		
# Nitrification Fields	1	# Lines	3	Linear Ft:	240'
EXIST Trench Width	3'	Max. Trench Bottom Depth		Gravel Depth	12"

☐ New System ☐ Repair ☐ Expansion System Type: ☐ I ☐ II ☐ III ☐ IV ☐ V ☐ VI

System Description: EXIST Gravity - Conventional

Repair System Description: Same

Maintenance Agreement Required: ☐ YES ☒ NO

☒ GRAVITY ☐ PRESSURE

☒ Residence ☐ Business ☐ Other ☐ Slab ☐ Basement w/plumbing

No. Bedrooms | No. Persons | No. Employees | ☐ Crawl Space


Water Supply: ☒ Private ☐ Public ☐ Community

☒ Basement w/o plumbing

Comments / Conditions:


Proposed Screened porch addition meets setbacks to well & Septic system.

INITIAL SITE SKETCH

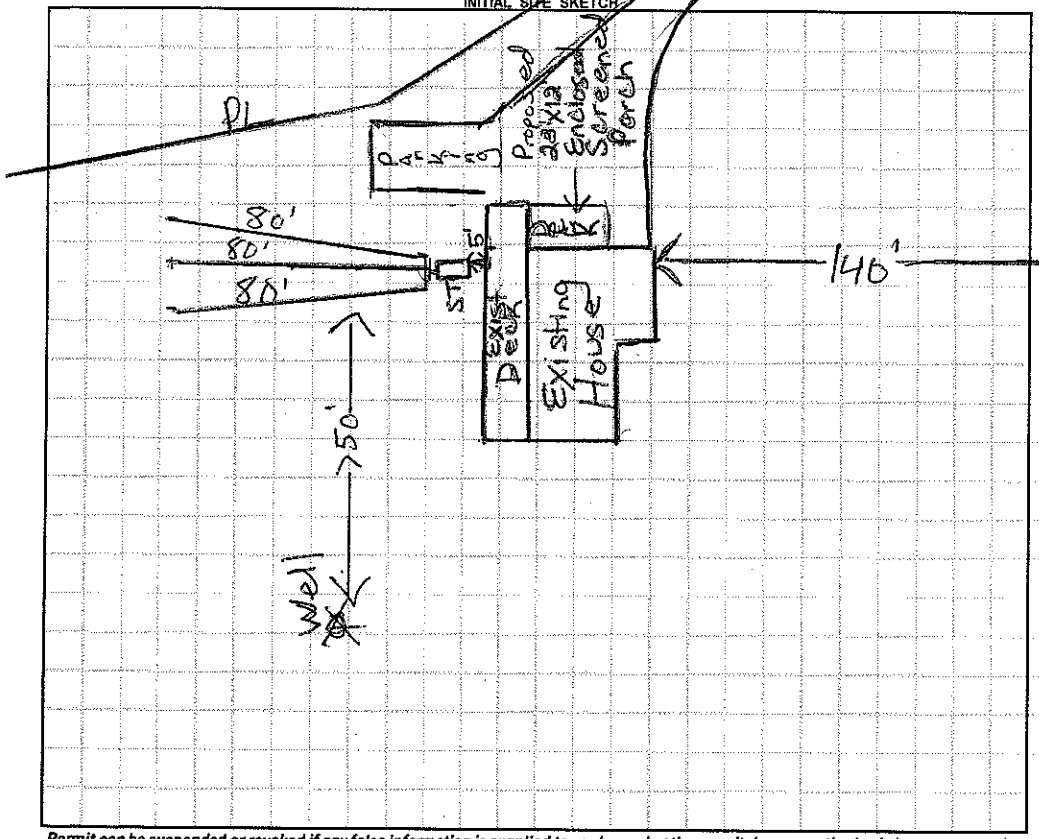

AS BUILT SKETCH

Scale 1:60

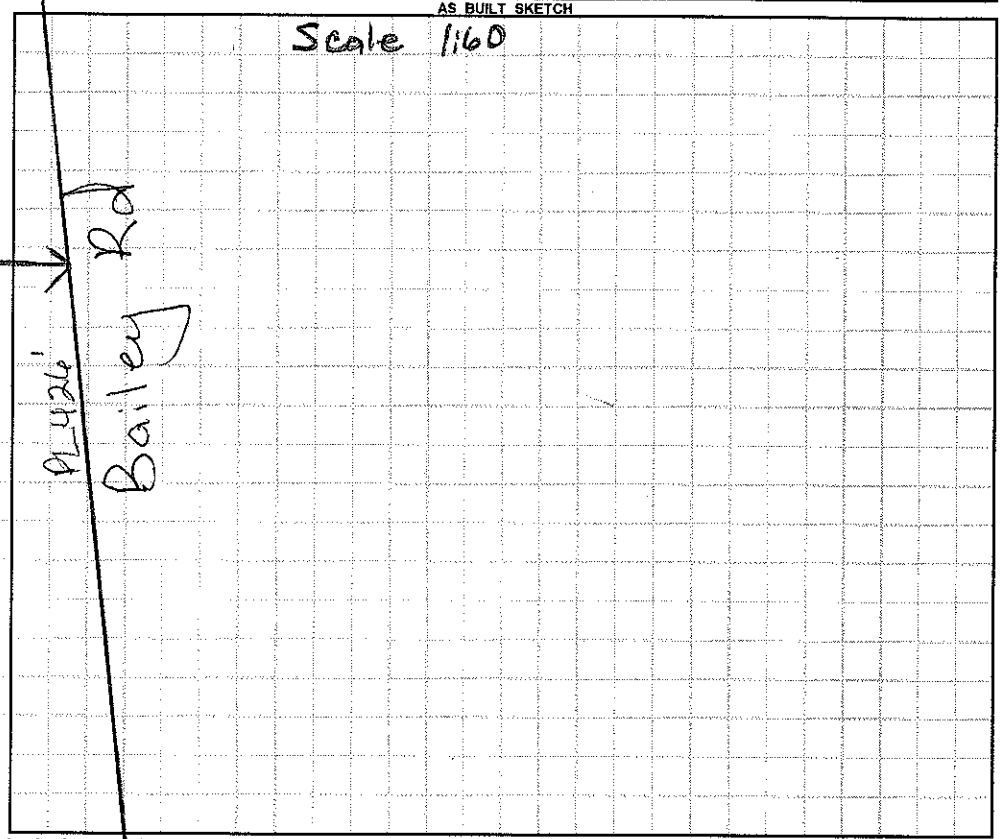

Permit can be suspended or revoked if any false information is supplied toward securing the permit / any unauthorized changes are made to the site / any unauthorized changes are made in the installation of the system. **CONTACT A LOCATOR SERVICE PRIOR TO ANY EXCAVATION**

☐ **IMPROVEMENT PERMIT** *with plat valid without expiration* ☒ **IMPROVEMENT PERMIT** *with site plan valid for 60 mos.* ☐ **AUTHORIZATION TO CONSTRUCT** *valid for period equal to IMPROVEMENT PERMIT--not to exceed 60 mo.*

Owner / Applicant Signature: [signature] Date: 4-1-16 Installed by:

IMPROVEMENT PERMIT by: Date: OPERATION PERMIT by: Date:

AUTHORIZATION TO CONSTRUCT by: Date: Existing System Inspected by: Maria Dotson RS Date: 3/29/16

Health Dept. Copy - WHITE Applicant (Final Approval) - YELLOW Applicant (Conditional Approval) - PINK