IREDELL COUNTY HEALTH DEPARTMENT

STATESVILLE 704-878-5305 130.00 Pg. 9 MOORESVILLE 704-664-5281

IMPROVEMENT PERMIT / AUTHORIZATION TO CONSTRUCT / OPERATION PERMIT / EXISTING SYSTEM INSPECTION

PERMIT# H1626 132429 PIN# 4658-17-1869

OWNER OR CONTRACTOR Brenden Phillips PHONE: Business 704-309-4424 Home DATE 2/3/04

ADDRESS 18817 Nautical Dr. Cornelius NC 28031

LOCATION 21 N, TL Cornelius, TR Olympia, TR Blake Ct 9th on Rt

SUBDIVISION Cornelius Est BLOCK / SECTION LOT 58 LOT AREA 0.8334 SITE CLASS. PS DESIGN FLOW 450 L.T.A.R. 0.5

Septic Tank: 1000 Gallons; STB 796 Date 12/05

Pump Tank: Gallons; PT Date

Pump Make: Model Serial No.

Nitrification Field: No Fields 1 Square Feet 1200 Linear Feet 400

No Lines 3@133' Trench Width 36" Max Trench Bottom Depth 36" Gravel Depth —

☒ New System ☐ Repair System Type: I, II, (III), IV, V, VI

System Description: Gravity 25% Reduct

Repair System Description: Same

Maintenance Agreement Required: ☐ Yes ☒ No

☒ House/Mod. Home ☐ Mobile Home ☐ Business ☐ Other

No. Bedrooms 4 No. Bathrooms 3 No. Employees

☐ Slab ☒ Crawl Space ☐ Basement w/plumbing ☐ Basement wo/plumbing


Water Supply: ☒ Individual ☐ Public ☐ Community

Comments/Conditions:


1"=50'

Comments:/Conditions:

INITIAL SITE SKETCH

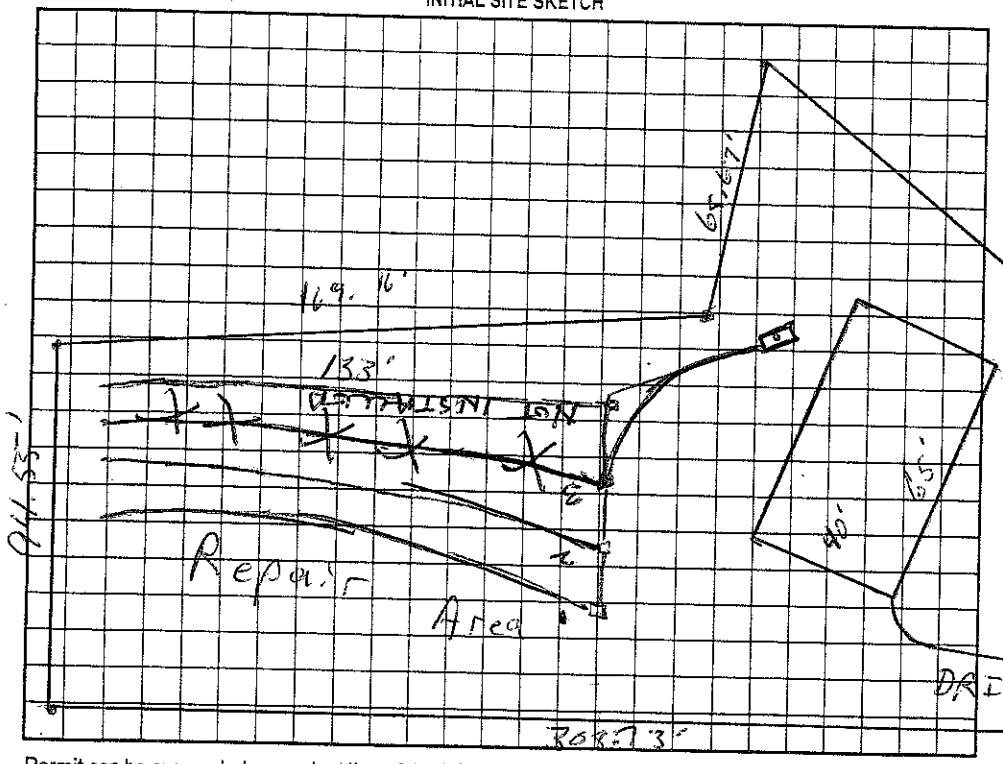

AS BUILT SKETCH

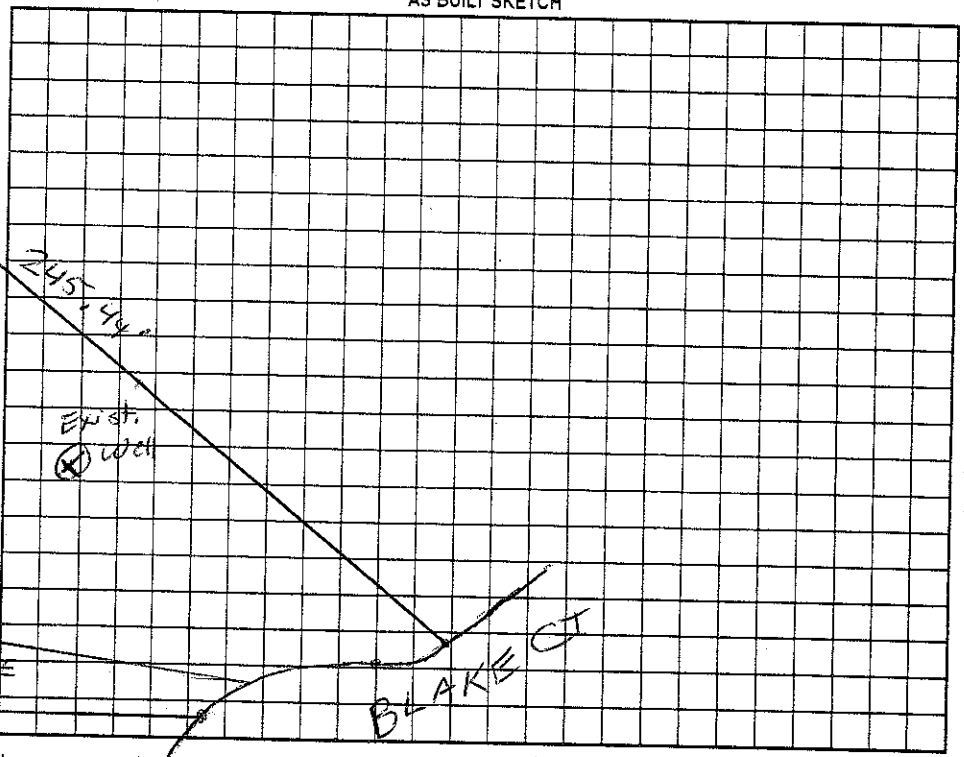

Permit can be suspended or revoked if any false information is supplied toward securing the permit/any unauthorized changes are made to the site/any unauthorized changes are made in the installation of the system. Improvement Permit with plat valid without expiration. Improvement Permit with site plan valid for sixty months. Authorization to Construct is valid for a period equal to that of Improvement Permit – not to exceed sixty months.

Signed: BCM date 02/05/04 Installed by: A+M Contracting

Improvement Permit by: RS date 2/3/04 Operation Permit by: Wesley Sprinkle RS. date 2/21/04

Authorization to Construct by: RS date 2/3/04 Existing System Inspection by: date

HEALTH DEPT. COPY: WHITE OWNER COPY (FINAL): YELLOW OWNER COPY (INITIAL): PINK