IREDELL COUNTY HEALTH DEPARTMENT

STATESVILLE 704-878-5305 MOORESVILLE 704-664-5281

IMPROVEMENT PERMIT / AUTHORIZATION TO CONSTRUCT / OPERATION PERMIT / EXISTING SYSTEM INSPECTION

PERMIT# 083905 PIN# 4658142733 DATE 10/7/99

OWNER OR CONTRACTOR Bobby Marshall PHONE: Business Home 664-1946

ADDRESS 147 Spring Run Dr. Mooresville, NC 28117

LOCATION 21 N TL Bailey Rd TR Warlick Dr. 2nd lot on left

SUBDIVISION BLOCK / SECTION ~~lot~~ 1.14 Acre LOT AREA Existing SITE CLASS. DESIGN FLOW 360 gpd L.T.A.R. Existing

Septic Tank: Existing Gallons; STB Date

Pump Tank: Gallons; PT Date

Pump Make: Model Serial No.

Nitrification Field: No Fields 1 Square Feet Linear Feet 75'

No Lines Bead Trench Width 5-7' Max Trench Bottom Depth 24-36" Gravel Depth 12"

☐ New System ☐ Repair System Type: I, II, III, IV, V, VI

System Description: Existing Gravity - Conventional

Repair System Description: Same

Maintenance Agreement Required: ☐ Yes ☒ No

☒ House/Mod. Home No. Bedrooms 3

☐ Mobile Home No. Bathrooms 2

☐ Business No. Employees

☐ Other


☐ Slab ☒ Crawl Space ☐ Basement w/plumbing ☐ Basement wo/plumbing

Water Supply: ☒ Individual ☐ Public ☐ Community

Comments/Conditions: Existing Septic System appears to be functioning okay. No problems noticed. Keep New home at least 5' from Existing Septic System

Comments/Conditions: System okay for 3 Bedroom

INITIAL SITE SKETCH Not to Scale

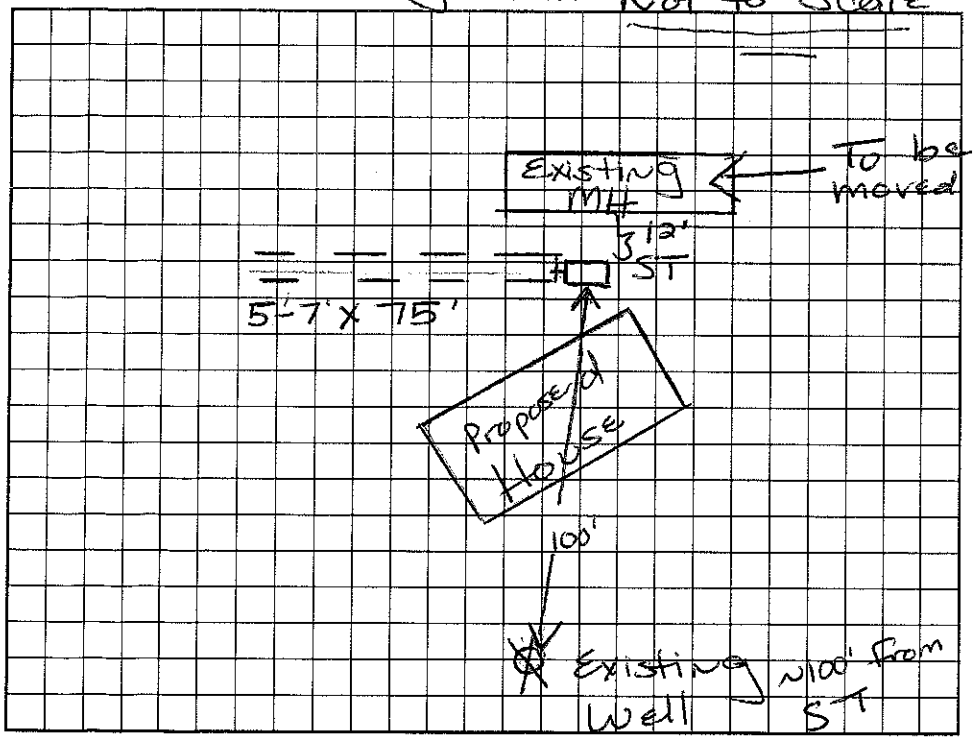

AS BUILT SKETCH

Permit can be suspended or revoked if any false information is supplied toward securing the permit/any unauthorized changes are made to the site/any unauthorized changes are made in the installation of the system. Improvement Permit with plat valid without expiration. Improvement Permit with site plan valid for sixty months. Authorization to Construct is valid for a period equal to that of Improvement Permit – not to exceed sixty months.

Signed: X Bobby A Marshall date

Improvement Permit by: Maria H. H. Dotson R.S. date 10/7/99

Authorization to Construct by: date

Installed by:

Operation Permit by: Maria H. H. Dotson R.S. date

Existing System Inspection by: Maria H. H. Dotson date 10/7/99

HEALTH DEPT. COPY: WHITE OWNER COPY (FINAL): YELLOW OWNER COPY (INITIAL): PINK