# IREDELL COUNTY HEALTH DEPARTMENT

STATESVILLE 704-878-5305 MOORESVILLE 704-664-5281

## IMPROVEMENT PERMIT / AUTHORIZATION TO CONSTRUCT / OPERATION PERMIT / EXISTING SYSTEM INSPECTION

PERMIT# No PIN# 4658200731 DATE 3/27/01

OWNER OR CONTRACTOR Mark Glover PHONE: Business Home 660-9123

ADDRESS 171 Valleyview Rd. Mooresville, NC. 28115

LOCATION 2 1/2 N TL Valleyview Rd. to #171 - 4th drive on (L)

SUBDIVISION OAKBROOK BLOCK / SECTION LOT 6 LOT AREA .74 SITE CLASS. [redacted] DESIGN FLOW 360 L.T.A.R. .3

Septic Tank: EXISTING Gallons; STB Date

Pump Tank: EXISTING Gallons; PT Date

Pump Make: Model Serial No.

Nitrification Field: No Fields 1 Square Feet 900 Linear Feet 300

No Lines ~~3 @ 100'~~ 4 @ 75' Trench Width 3' Max Trench Bottom Depth 3' Gravel Depth No

☐ New System ☒ Repair System Type: I, II, (III), IV, V, VI

System Description:

Repair System Description: HDS of Chem. Plastic

Maintenance Agreement Required: ☐ Yes ☒ No

☒ House/Mod. Home No. Bedrooms 3

☐ Mobile Home No. Bathrooms 2.5

☐ Business No. Employees

☐ Other


☐ Slab ☒ Crawl Space ☐ Basement w/plumbing ☐ Basement wo/plumbing

Water Supply: ☒ Individual ☐ Public ☐ Community


Comments/Conditions: Close valve to original Pres. Manifold T into supply line and install new Manifold and drainlines

Comments/Conditions: 4 @ 75' x 3'

INITIAL SITE SKETCH 1"=50'

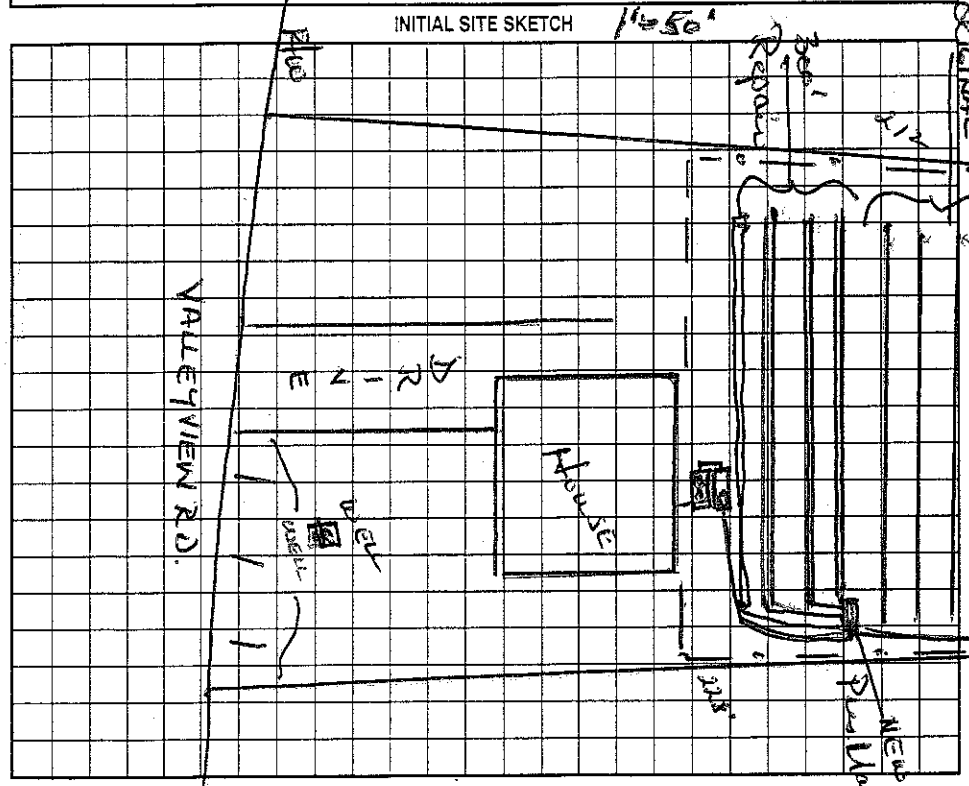


AS BUILT SKETCH

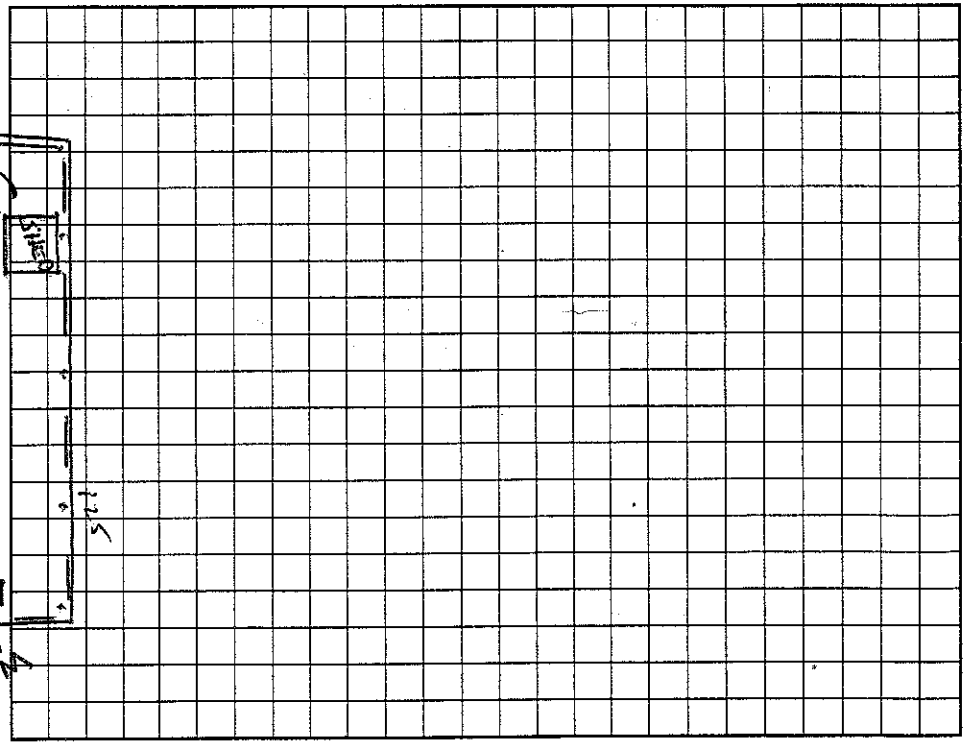


Permit can be suspended or revoked if any false information is supplied toward securing the permit/any unauthorized changes are made to the site/any unauthorized changes are made in the installation of the system. Improvement Permit with plat valid without expiration. Improvement Permit with site plan valid for sixty months. Authorization to Construct is valid for a period equal to that of Improvement Permit – not to exceed sixty months.

Signed: [signature] date 3/30/01

Improvement Permit by: date

Authorization to Construct by: Wesley Sparks RS. date 3/27/01

Installed by: Rowan Septic

Operation Permit by: Wesley Sparks RS. date 4/12/01

Existing System Inspection by: date

HEALTH DEPT. COPY: WHITE OWNER COPY (FINAL): YELLOW OWNER COPY (INITIAL): PINK

3:30

# IREDELL COUNTY HEALTH DEPARTMENT Const. Auth STATESVILLE 704-878-5305 MOORESVILLE 704-664-5281

## IMPROVEMENT PERMIT / ~~CERTIFICATE OF COMPLETION~~ / OPERATION PERMIT / EXISTING SYSTEM INSPECTION

PROPERTY DESCRIPTION NO. 24585 DATE Feb 1, '97 TAX MAP NO. part of 1645 Watershed: ☑ Yes ☐ No

OWNER OR CONTRACTOR from Financial Services PHONE: Business 664-3671 Home

ADDRESS 149 Yacht Rd, Mooresville NC

LOCATION US 21N TL Valleyview on left

SUBDIVISION Oakbrook BLOCK / SECTION LOT 6 LOT AREA .74Ac SITE CLASS. PS DESIGN FLOW 360gpd L.T.A.R. .3

Septic Tank: 1000 Gallons; STB 826 Date 12/11/97

Pump Tank: 1000 Gallons; PT 47 Date 2/11/98

Pump Make: ZOELLER Model M137 Serial No.

Nitrification Field: No Fields 1 Square Feet 1200 Linear Feet 400

No Lines 4@100' Trench Width 36" Max Trench Bottom Depth 24" Gravel Depth 12"

☑ New System ☐ Repair System Type: I, II, III, IV, V, VI

System Description: pumped-pressure - conventional

Repair System Description: same

Maintenance Agreement Required: ☐ Yes ☑ No

☑ House/Mod. Home No. Bedrooms 3

☐ Mobile Home No. Bathrooms 2

☐ Business No. Employees

☐ Other

☐ Slab ☑ Crawl Space ☐ Basement w/plumbing ☐ Basement wo/plumbing


Water Supply: ☑ Individual ☐ Community ☐ Public

Comments:


Comments:

### INITIAL SITE SKETCH

1"=50'

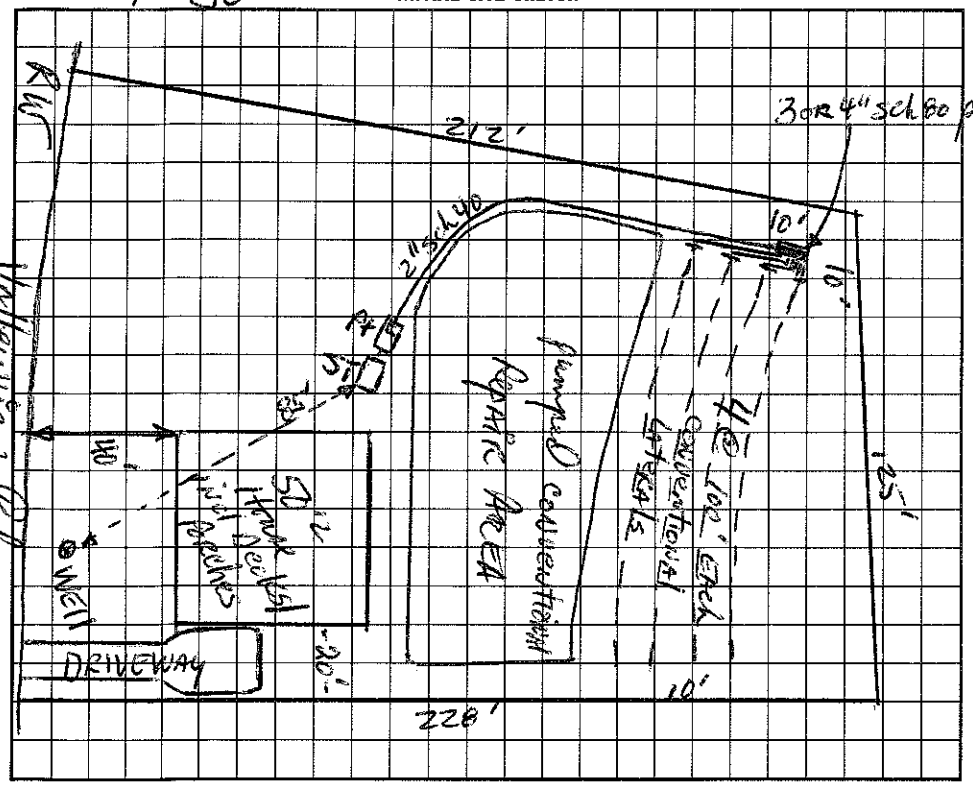


### AS BUILT SKETCH

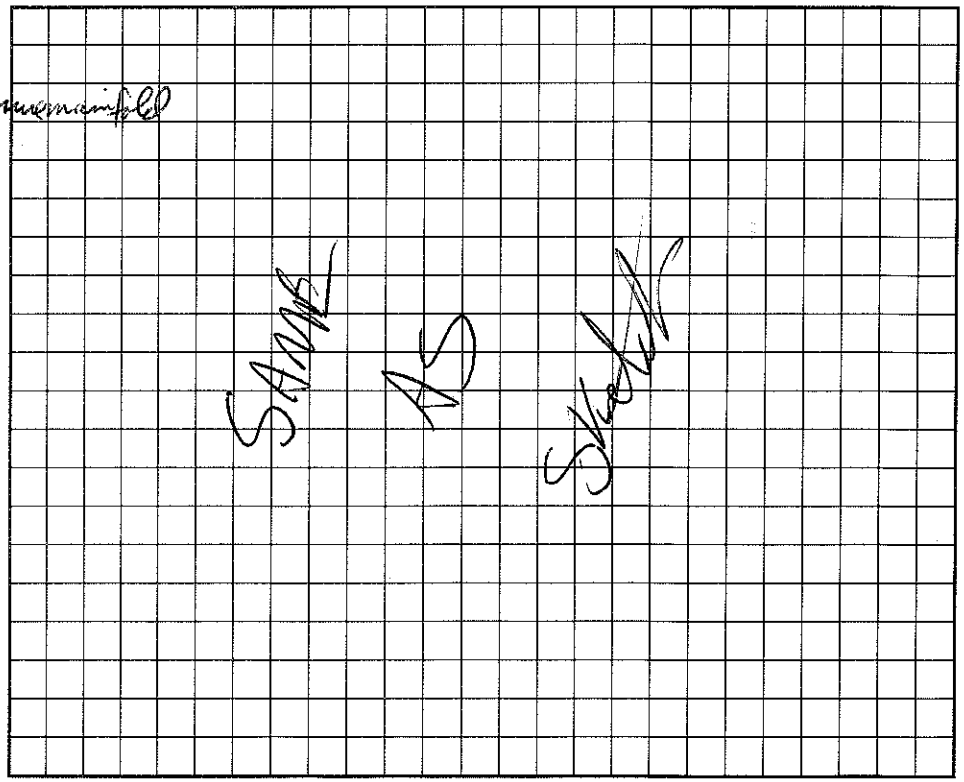


I understand that this permit can be suspended or revoked if any false information is supplied toward securing the permit/any unauthorized changes are made to the site/any unauthorized changes are made in the installation of the system. Improvement Permit is valid for 60 months from date of issuance.

Signed:

Improvement Permit by: RS date 2-1-97

~~Existing System~~ Inspection by: RS date 2-1-97

Installed by: ROWAN SEPTIC

Certificate of Completion by: date

Operation Permit by: RS date 3/19/98

CONSTRUCTION AUTHORIZATION

HEALTH DEPT. COPY: WHITE INSPECTION COPY (FINAL): GREEN OWNER COPY (FINAL): YELLOW INSPECTION COPY (INITIAL): PINK OWNER COPY (INITIAL): GOLD