IREDELL COUNTY HEALTH DEPARTMENT

STATESVILLE 704-878-5305 MOORESVILLE 704-664-5281

IMPROVEMENT PERMIT / AUTHORIZATION TO CONSTRUCT / OPERATION PERMIT / EXISTING SYSTEM INSPECTION

PERMIT# No PIN# 4658200731 DATE 3/27/01

OWNER OR CONTRACTOR Mark Glover PHONE: Business Home 660-9123

ADDRESS 171 Valleyview Rd. Mooresville, NC. 28115

LOCATION 2 IN TL Valleyview Rd to #171 - to drive on (L)

SUBDIVISION OAKBROOK BLOCK / SECTION LOT 6 LOT AREA .74 SITE CLASS. [redacted] DESIGN FLOW 360 L.T.A.R. .3

Septic Tank: EXISTING Gallons; STB Date

Pump Tank: EXISTING Gallons; PT Date

Pump Make: Model Serial No.

Nitrification Field: No Fields 1 Square Feet 900 Linear Feet 300

No Lines ~~3 @ 100'~~ 4 @ 75' Trench Width 3' Max Trench Bottom Depth 3' Gravel Depth No

☐ New System ☒ Repair System Type: I, II, (III), IV, V, VI

System Description:

Repair System Description: HAS of Chem. Pkoste

Maintenance Agreement Required: ☐ Yes ☒ No

☒ House/Mod. Home No. Bedrooms 3

☐ Mobile Home No. Bathrooms 2.5

☐ Business No. Employees

☐ Other


☐ Slab ☒ Crawl Space ☐ Basement w/plumbing ☐ Basement wo/plumbing

Water Supply: ☒ Individual ☐ Public ☐ Community


Comments/Conditions: Close valve to original Pres. Manifold T into supply line and install new Manifold and drainlines

Comments/Conditions: 4 @ 75' x 3'

INITIAL SITE SKETCH 1"=50'

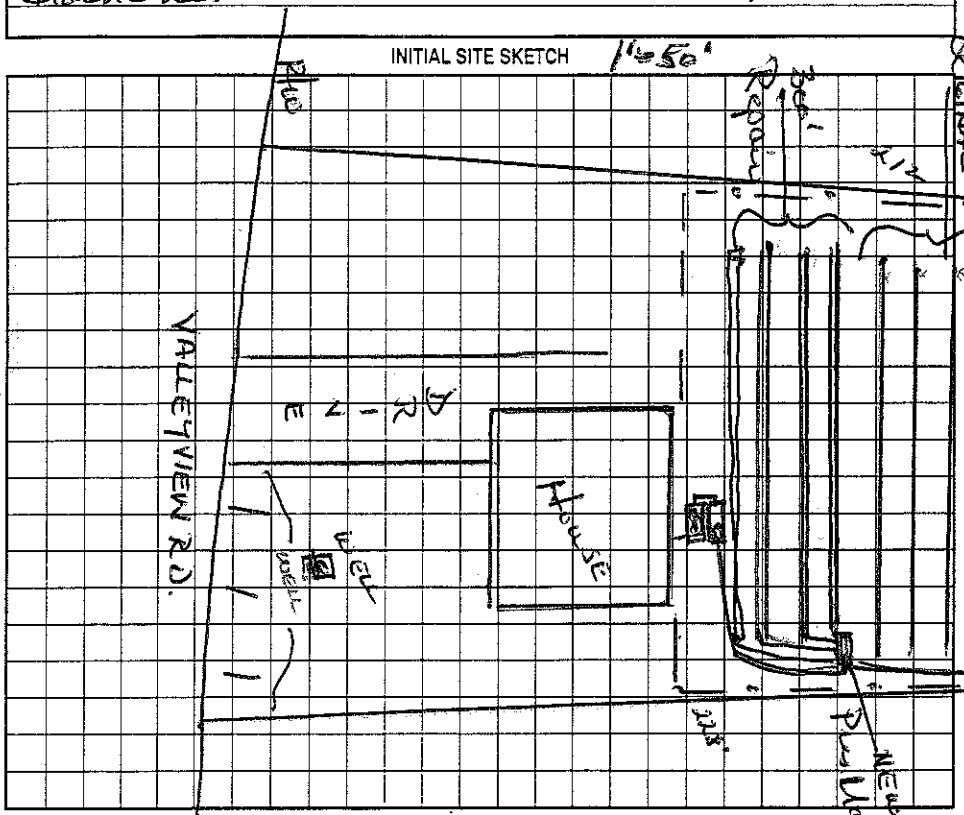

AS BUILT SKETCH

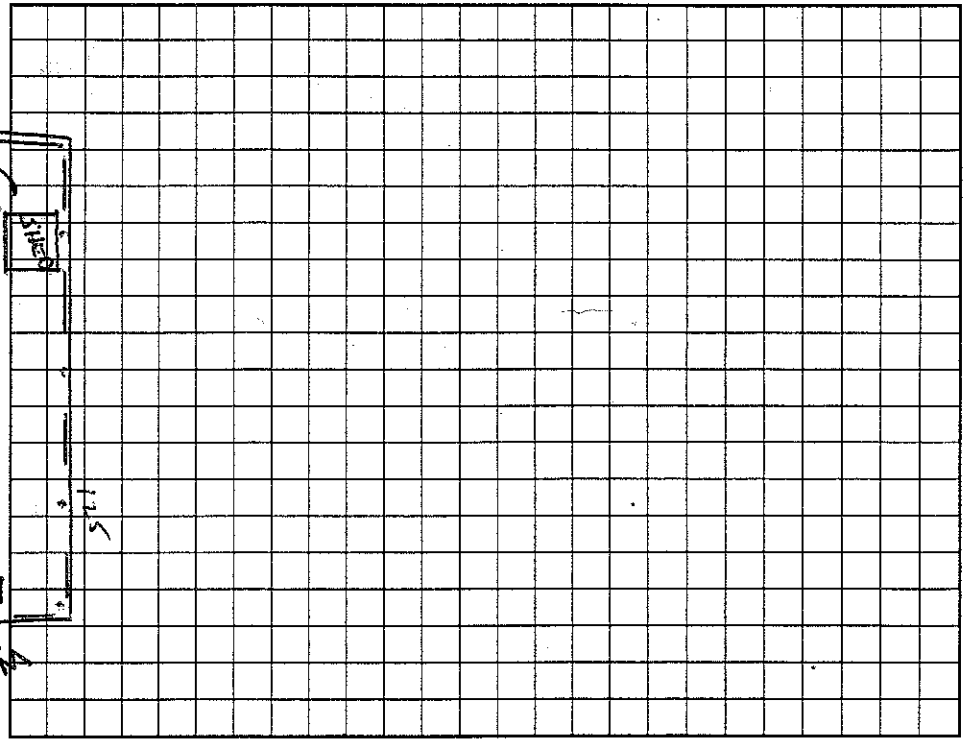

Permit can be suspended or revoked if any false information is supplied toward securing the permit/any unauthorized changes are made to the site/any unauthorized changes are made in the installation of the system. Improvement Permit with plat valid without expiration. Improvement Permit with site plan valid for sixty months. Authorization to Construct is valid for a period equal to that of Improvement Permit – not to exceed sixty months.

Signed: [signature] date 3/30/01

Improvement Permit by: date

Authorization to Construct by: Wesley Sparks RS. date 3/27/01

Installed by: Rowan Septic

Operation Permit by: Wesley Sparks RS. date 4/12/01

Existing System Inspection by: date

HEALTH DEPT. COPY: WHITE OWNER COPY (FINAL): YELLOW OWNER COPY (INITIAL): PINK