IREDELL COUNTY HEALTH DEPARTMENT Const. Auth

STATESVILLE 704-878-5305 MOORESVILLE 704-664-5281

~~IMPROVEMENT PERMIT / CERTIFICATE OF COMPLETION~~ / OPERATION PERMIT / EXISTING SYSTEM INSPECT.

PROPERTY DESCRIPTION NO. 24667 DATE Sept 3, '97 TAX MAP NO. part of 1145 4658 20 1698 Watershed: ☐ Yes ☐ No

OWNER OR CONTRACTOR Krom Financial Services PHONE: Business Home

ADDRESS 149 Yacht Cove Rd Mooresville

LOCATION 2 mi NL TL Valley View on left

SUBDIVISION Oakbrooke BLOCK / SECTION LOT 5 LOT AREA .54Ac SITE CLASS PS DESIGN FLOW 360gpd L.T.A.R. .3

Septic Tank: 1000 Gallons; STB 825 Date 5/11/98

Pump Tank: 1000 Gallons; PT 47 Date 4/20/94

Pump Make: Zoeller Model N137-C Serial No. 315198

Nitrification Field: No Fields 1 Square Feet 1200 Linear Feet 400

No Lines 4@100' Trench Width 36" Max Trench Bottom Depth 24" Gravel Depth 12"

☑ New System ☐ Repair System Type: I, II, III, IV, V, VI.

System Description: pumped-pm-conventional

Repair System Description: same

Maintenance Agreement Required: ☐ Yes ☑ No

☑ House/Mod. Home No. Bedrooms 3

☐ Mobile Home No. Bathrooms 2

☐ Business No. Employees

☐ Other


☐ Slab ☑ Crawl Space ☐ Basement w/plumbing ☐ Basement wo/plumbing

Water Supply: ☑ Individual ☐ Community ☐ Public

Comments:

Comments:

INITIAL SITE SKETCH 1"=100'

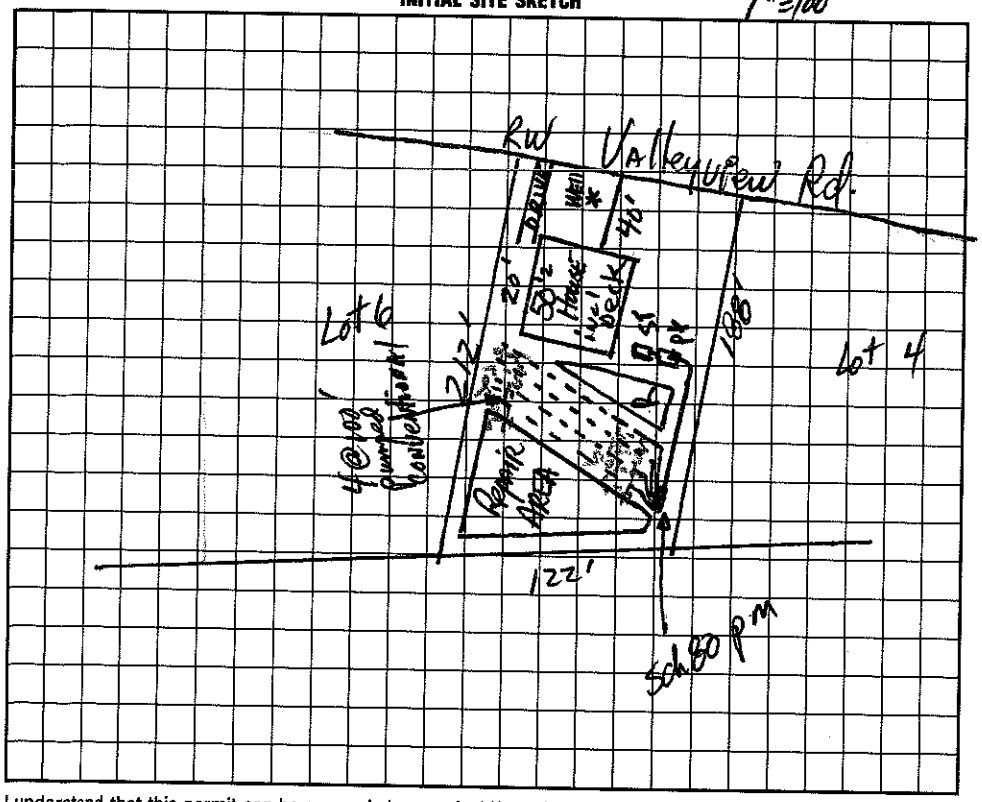

AS BUILT SKETCH

I understand that this permit can be suspended or revoked if any false information is supplied toward securing the permit/any unauthorized changes are made to the site/any unauthorized changes are made in the installation of the system. Improvement Permit is valid for 60 months from date of issuance.

Signed:

Improvement Permit by: DR Jamison RS date 9-3-97

~~Existing System Inspection by:~~ Construction Authorization DR Jamison RS date 9-3-97

Installed by: Rowan Septic Tank

Certificate of Completion by: Wesley Sparks RS date 7/31/98

Operation Permit by: Wesley Sparks RS date 7/31/98

HEALTH DEPT. COPY: WHITE INSPECTION COPY (FINAL): GREEN OWNER COPY (FINAL): YELLOW INSPECTION COPY (INITIAL): PINK OWNER COPY (INITIAL): GOLD