IREDELL COUNTY HEALTH DEPARTMENT Const. Auth STATESVILLE 704-878-5305 MOORESVILLE 704-664-5281

IMPROVEMENT PERMIT / ~~CERTIFICATE OF COMPLETION~~ / OPERATION PERMIT / EXISTING SYSTEM INSPECTION

PROPERTY DESCRIPTION NO. 24583 DATE Sept. 3, '97 TAX MAP NO. part of 1LA5 4658 20 3654 Watershed: ☐ Yes ☐ No

OWNER OR CONTRACTOR Ryan Financial Services PHONE: Business _____ Home _____

ADDRESS 149 Yacht Cove RD Mooresville

LOCATION I 21 N. TL Valleyview on left

SUBDIVISION Oakbrook BLOCK / SECTION _____ LOT 4 LOT AREA 1 AC SITE CLASS. B5 DESIGN FLOW 360 gpd L.T.A.R. ~.3

Septic Tank: 1000 Gallons; STB 825 Date 6/21/99

Pump Tank: 1000 Gallons; PT 47 Date 6/21/99

Pump Make: Zoeller Model N163-F Serial No. 2/25/99

Nitrification Field: No Fields 1 Square Feet 900 Linear Feet 300

No Lines 3@100' Trench Width 36" Max Trench Bottom Depth 24" Gravel Depth NA

☑ New System ☐ Repair System Type: I, II, (III) IV, V, VI

System Description: pumped-pm-chambered

Repair System Description: Same

Maintenance Agreement Required: ☐ Yes ☑ No

☑ House/Mod. Home No. Bedrooms 3

☐ Mobile Home No. Bathrooms 2

☐ Business No. Employees _____

☐ Other _____


☐ Slab ☑ Crawl Space ☐ Basement w/plumbing ☐ Basement wo/plumbing

Water Supply: ☑ Individual ☐ Community ☐ Public

Comments: ONLY inspection port per lateral

Comments:

INITIAL SITE SKETCH 1" = 100'

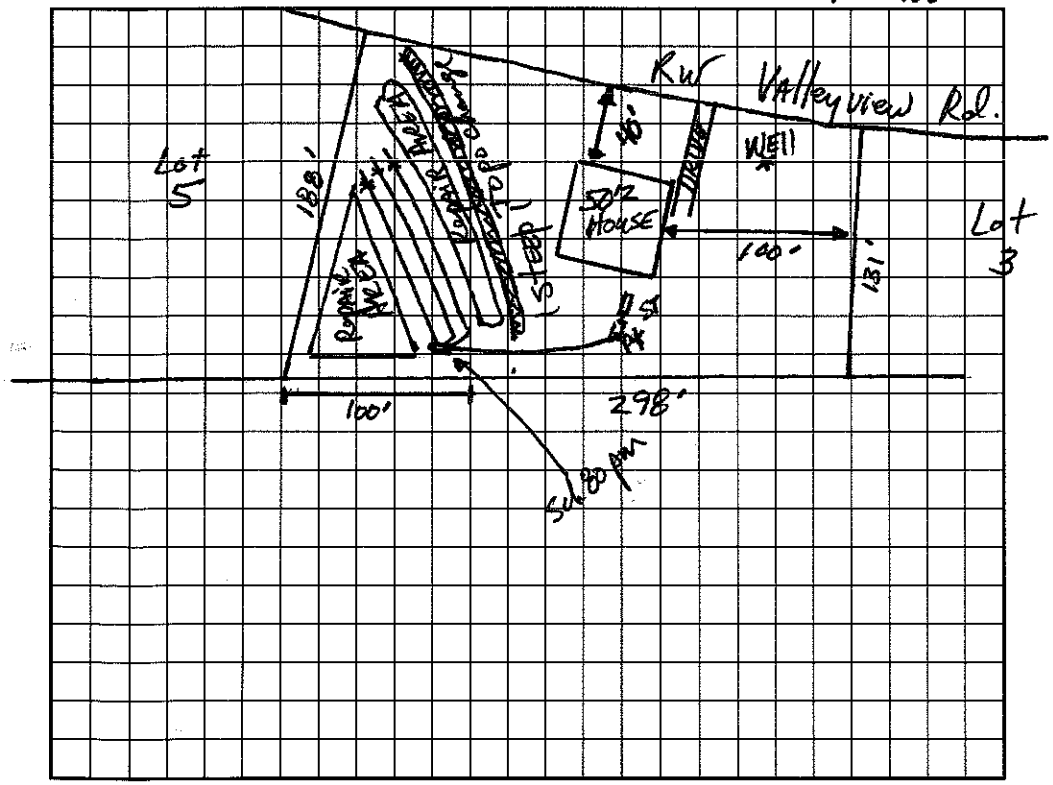

AS BUILT SKETCH

I understand that this permit can be suspended or revoked if any false information is supplied toward securing the permit/any unauthorized changes are made to the site/any unauthorized changes are made in the installation of the system. Improvement Permit is valid for 60 months from date of issuance.

Signed: _____

Improvement Permit by: _____ date 9-3-97

Construction ~~Repair~~ Inspection by: _____ date 9-3-97

Installed by: Rowan Septic Tank

Certificate of Completion by: _____ date 8/27/99

Operation Permit by: _____ date 8/27/99

HEALTH DEPT. COPY: WHITE INSPECTION COPY (FINAL): GREEN OWNER COPY (FINAL): YELLOW INSPECTION COPY (INITIAL): PINK OWNER COPY (INITIAL): GOLD