3:30

IREDELL COUNTY HEALTH DEPARTMENT Const. Auth

STATESVILLE 704-878-5305 MOORESVILLE 704-664-5281

IMPROVEMENT PERMIT / ~~CERTIFICATE OF COMPLETION~~ / OPERATION PERMIT / EXISTING SYSTEM INSPECTION

PROPERTY DESCRIPTION NO. 24582 DATE September 2, '97 TAX MAP NO. part of 11A5 4658 206650 Watershed: ☑ Yes ☐ No

OWNER OR CONTRACTOR From Financial Services PHONE: Business _____ Home _____

ADDRESS 149 Yacht Cove Rd Mooresville N.C.

LOCATION 21 N. to Valleyview Rd. on left

SUBDIVISION Oakbrook BLOCK / SECTION _____ LOT 3 LOT AREA 1.98 Ac SITE CLASS. A5 DESIGN FLOW 360 gpd L.T.A.R. ~.3

Septic Tank: 1000 Gallons; STB 823 Date 6/5/98

Pump Tank: 1000 Gallons; PT 47 Date 7/8/98

Pump Make: ~~Environ-Flo~~ Model M157 Serial No. _____

Nitrification Field: No Fields 1 Square Feet 1200 Linear Feet 400

No Lines 5@80' Trench Width 36" Max Trench Bottom Depth 36" Gravel Depth 12"

☑ New System ☐ Repair System Type: I, II, III, IV, V, VI

System Description: pumped-pm- Conventional

Repair System Description: same

Maintenance Agreement Required: ☐ Yes ☑ No

☑ House/Mod. Home No. Bedrooms 3

☐ Mobile Home No. Bathrooms 2

☐ Business No. Employees _____

☐ Other _____


☐ Slab ☑ Crawl Space ☐ Basement w/plumbing ☐ Basement wo/plumbing

Water Supply: ☑ Individual ☐ Community ☐ Public

Comments:

Comments:

INITIAL SITE SKETCH 1" = 100'

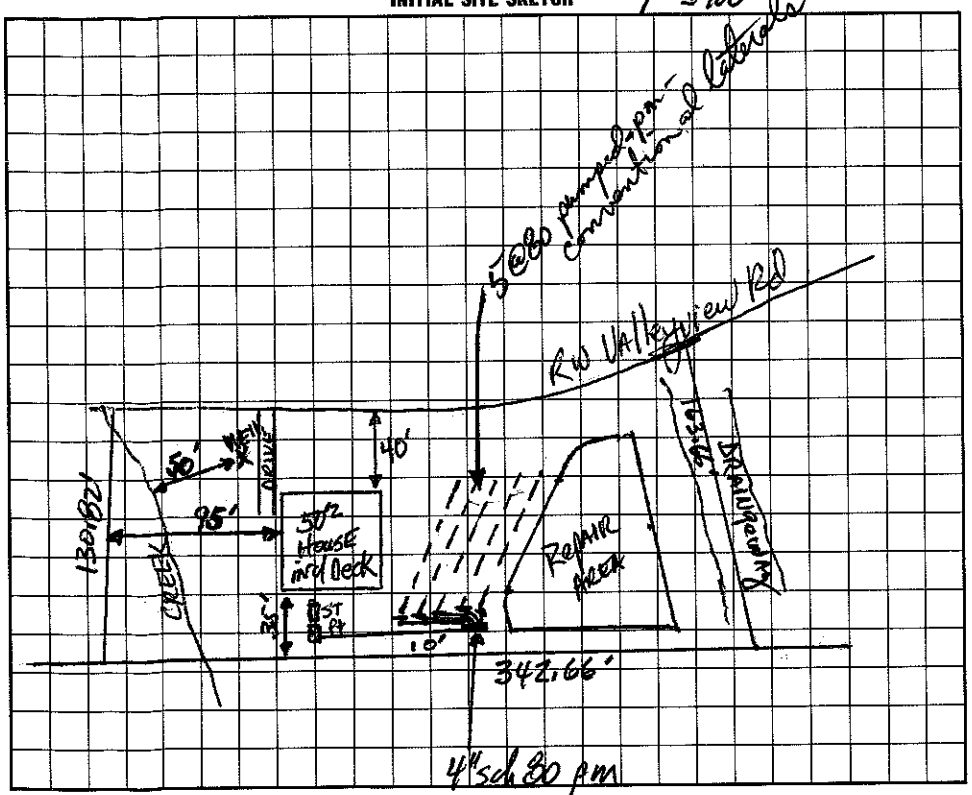

AS BUILT SKETCH

I understand that this permit can be suspended or revoked if any false information is supplied toward securing the permit/any unauthorized changes are made to the site/any unauthorized changes are made in the installation of the system. Improvement Permit is valid for 60 months from date of issuance.

Permit by: D. Harrison RS date 9-2-97

~~Construction~~ by: D. Harrison RS date 9-2-97

Installed by: Rowan Septic Tank

Certificate of Completion by: Wesley Sparks R.S. date 7/31/98

Operation Permit by: Wesley Sparks R.S. date 7/31/98

DEPT. COPY: WHITE INSPECTION COPY (FINAL): GREEN OWNER COPY (FINAL): YELLOW INSPECTION COPY (INITIAL): PINK OWNER COPY (INITIAL): GOLD