IREDELL COUNTY HEALTH DEPARTMENT

Const. Auth (4700) STATESVILLE 704-878-5305 MOORESVILLE 704-664-5281

IMPROVEMENT PERMIT / ~~CERTIFICATE OF COMPLETION~~ / OPERATION PERMIT / EXISTING SYSTEM INSPECTION

PROPERTY DESCRIPTION NO. 24664 DATE Aug 21, '97 TAX MAP NO. part of TLA5 4658320051 Watershed: ☑ Yes ☐ No

OWNER OR CONTRACTOR Kom Financial Services PHONE: Business _____ Home _____

ADDRESS 149 Yacht Cove Rd, Mooresville

LOCATION US 21 N. TL Valleyview TR Brooktree 1st lot (corner lot) on Rt

SUBDIVISION Oakbrook BLOCK / SECTION _____ LOT 85 LOT AREA 1.57Ac SITE CLASS. RS DESIGN FLOW 360gpd L.T.A.R. .3

Septic Tank: 1000 Gallons; STB ~~825~~ Date ~~3/14/90~~ 1/97

Pump Tank: 1000 Gallons; PT 47 Date 3/14/90

Pump Make: Zoeller Model N95-B Serial No. 1110

Nitrification Field: No Fields ___ Square Feet 1200 Linear Feet 400

No Lines ~~5@80'~~ Trench Width 36" Max Trench Bottom Depth ~18" Gravel Depth 12"

☐ New System ☐ Repair System Type: I, II, ☑ III, IV, V, VI

System Description: pumped-pm- conventional

Repair System Description: same

Maintenance Agreement Required: ☐ Yes ☑ No

☑ House/Mod. Home No. Bedrooms 3

☐ Mobile Home No. Bathrooms 2

☐ Business No. Employees ___

☐ Other _____


☑ Slab ☐ Crawl Space ☐ Basement w/plumbing ☐ Basement wo/plumbing

Water Supply: ☑ Individual ☐ Community ☐ Public

Comments: 4@100'

Comments:

INITIAL SITE SKETCH 1" = 100'

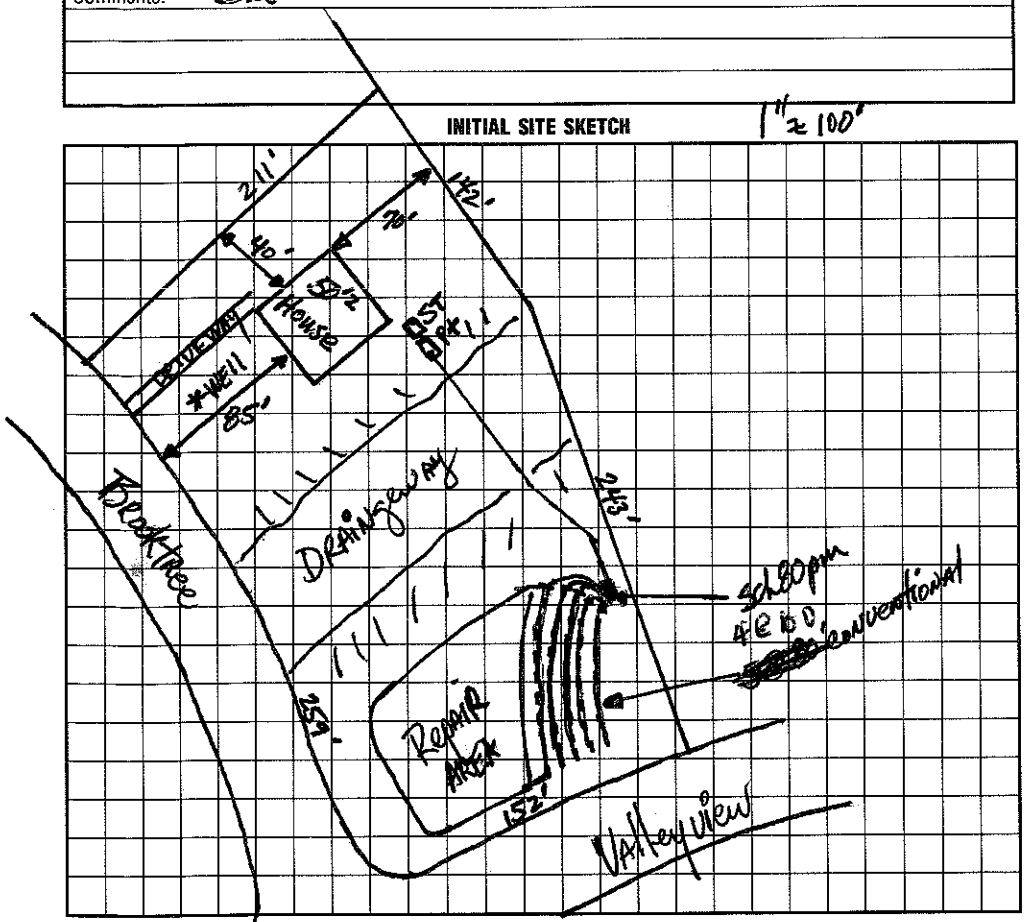

AS BUILT SKETCH

I understand that this permit can be suspended or revoked if any false information is supplied toward securing the permit/any unauthorized changes are made to the site/any unauthorized changes are made in the installation of the system. Improvement Permit is valid for 60 months from date of issuance.

Signed: _____

Improvement Permit by: DHoffman, RS date 8-21-97

~~Construction~~ Authorization by: DHoffman, RS date 8-21-97

Installed by: ROWAN SEPTIC

Certificate of Completion by: _____ date _____

Operation Permit by: _____ date 5/6/98

HEALTH DEPT. COPY: WHITE INSPECTION COPY (FINAL): GREEN OWNER COPY (FINAL): YELLOW INSPECTION COPY (INITIAL): PINK OWNER COPY (INITIAL): GOLD