ELL COUNTY HEALTH DEPARTMENT Cons. Auth. STATESVILLE 704-878-5305 MOORESVILLE 704-664-5281

IMPROVEMENT PERMIT / ~~CERTIFICATE OF COMPLETION~~ / OPERATION PERMIT / EXISTING SYSTEM INSPECTION

Watershed: ☑ Yes ☐ No

PROPERTY DESCRIPTION NO. 2445 DATE Oct 10, '97 TAX MAP NO. part of 1145

OWNER OR CONTRACTOR Krom Financial Services PHONE: Business ~~Home~~ 4658-21-6091

ADDRESS 149 Yacht Cove Rd Mooresville

LOCATION 21 N (T2 Valleyview) on right before Patrose Lane

SUBDIVISION Oakbrooke BLOCK / SECTION LOT 66 LOT AREA 1.05 Ac SITE CLASS. P5 DESIGN FLOW 360gpd L.T.A.R. no 4

Septic Tank: 1000 Gallons; STB 825 Date 5/7/97

Pump Tank: Gallons; PT Date

Pump Make: Model Serial No.

Nitrification Field: No Fields 1 Square Feet 900 Linear Feet 300

No Lines 4@75' Trench Width 36" Trench Bottom Depth 36" Gravel Depth 12"

☑ New System ☐ Repair System Type: I, II, III, IV, V, VI

System Description: gravity conventional same

Repair System Description:

Maintenance Agreement Required: ☐ Yes ☑ No

☑ House/Mod. Home No. Bedrooms 3

☐ Mobile Home No. Bathrooms 2

☐ Business No. Employees

☐ Other

☑ Slab ☑ Crawl Space ☐ Basement w/plumbing ☐ Basement wo/plumbing


Water Supply: ☑ Individual ☐ Community ☐ Public

Comments: Install all trenches at 36" trench bottom depth into saprolite

100' minimum separation from this system to all wells

Comments:

INITIAL SITE SKETCH

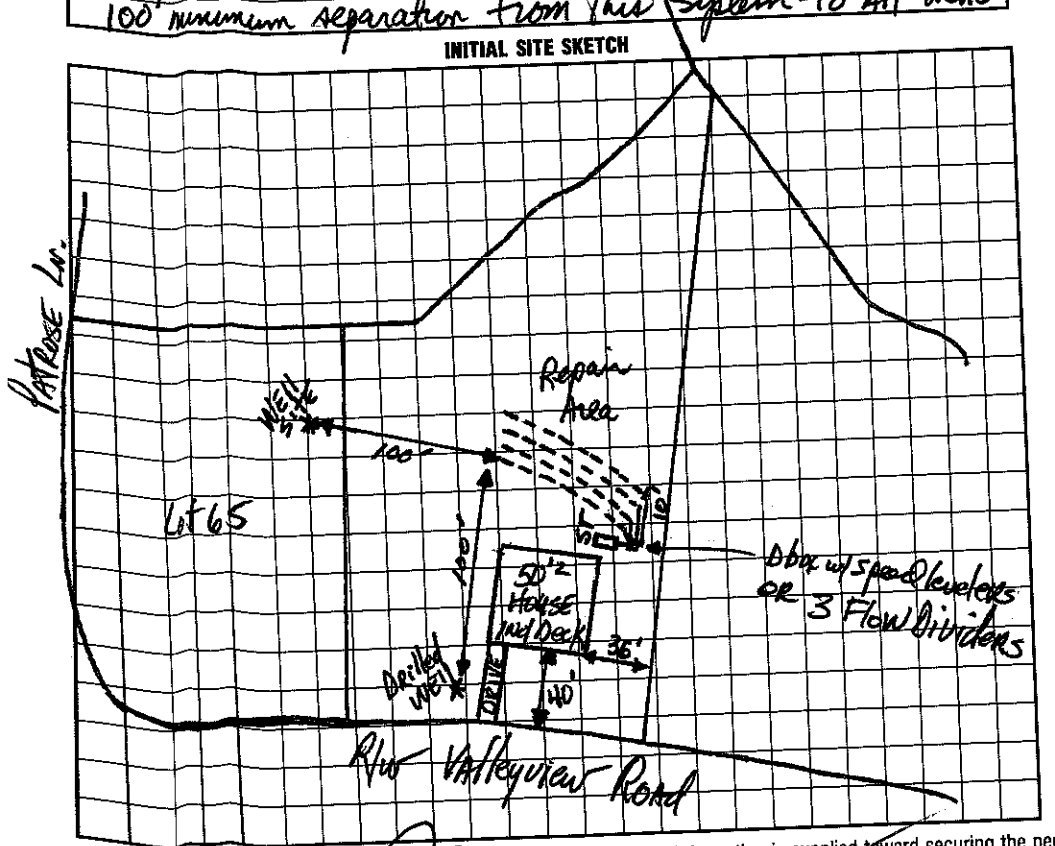

AS BUILT SKETCH

I understand that this permit can be suspended or revoked if any false information is supplied toward securing the permit/any unauthorized changes are made to the site/any unauthorized changes are made in the installation of the system. Improvement Permit is valid for 60 months from date of issuance.

Signed: date 10-10-97

Improvement Permit by: date 10-10-97

~~Construction Inspection~~ Final Inspection by:

Installed by: ROWAN SEPTIC date

Certificate of Completion by: date 6/30/97

Operation Permit by:

HEALTH DEPT. COPY: WHITE INSPECTION COPY (FINAL): GREEN OWNER COPY (FINAL): YELLOW INSPECTION COPY (INITIAL): PINK OWNER COPY (INITIAL): GOLD