IREDELL COUNTY HEALTH DEPARTMENT

Statesville Office (704) 878-5305 Mooresville Office (704) 660-3625 PERMIT # 220985

IMPROVEMENT PERMIT / AUTHORIZATION TO CONSTRUCT / OPERATION PERMIT / EXISTING SYSTEM

PIN # 4658-21-0221

APPLICANT: BETTY STILES APPLICANT ADDRESS: 118 PATROSE LN - Mooresville

SITE ADDRESS: SAME PHONE: 704-402-6500 ALT. PHONE:

SITE DIRECTIONS: I-77 N, TL VALLYVIEW, TR PATROSE, ON R

SUBDIVISION: OAK BROOK SECTION: LOT # 64 LOT AREA: 1.62 AC DESIGN FLOW: 360 L.T.A.R.: .3


Septic Tank	1000 (gal)	STB	T60	Date	1-18-16	☐ New System ☑ Repair ☐ Expansion	System Type: I II (III) IV V VI	☑ Residence	No. Bedrooms 3
Pump Tank	(gal)	PT		Date		System Description:		☐ Business	No. Persons 6
Pump Make		Model		Serial #		Repair System Description:	TANK	☐ Other	No. Employees
# Nitrification Fields		# Lines	EXISTING	Linear Ft:		Maintenance Agreement Required:	☐ YES ☑ NO	☐ Slab	☑ Crawl Space
Trench Width		Max. Trench Bottom Depth		Gravel Depth		☑ GRAVITY	☐ PRESSURE	☐ Basement w/plumbing	☐ Basement w/o plumbing

Water Supply: ☑ Private ☐ Public ☐ Community


Comments / Conditions:

* PUMP, CRUSH & FILL OLD TANK

INITIAL SITE SKETCH

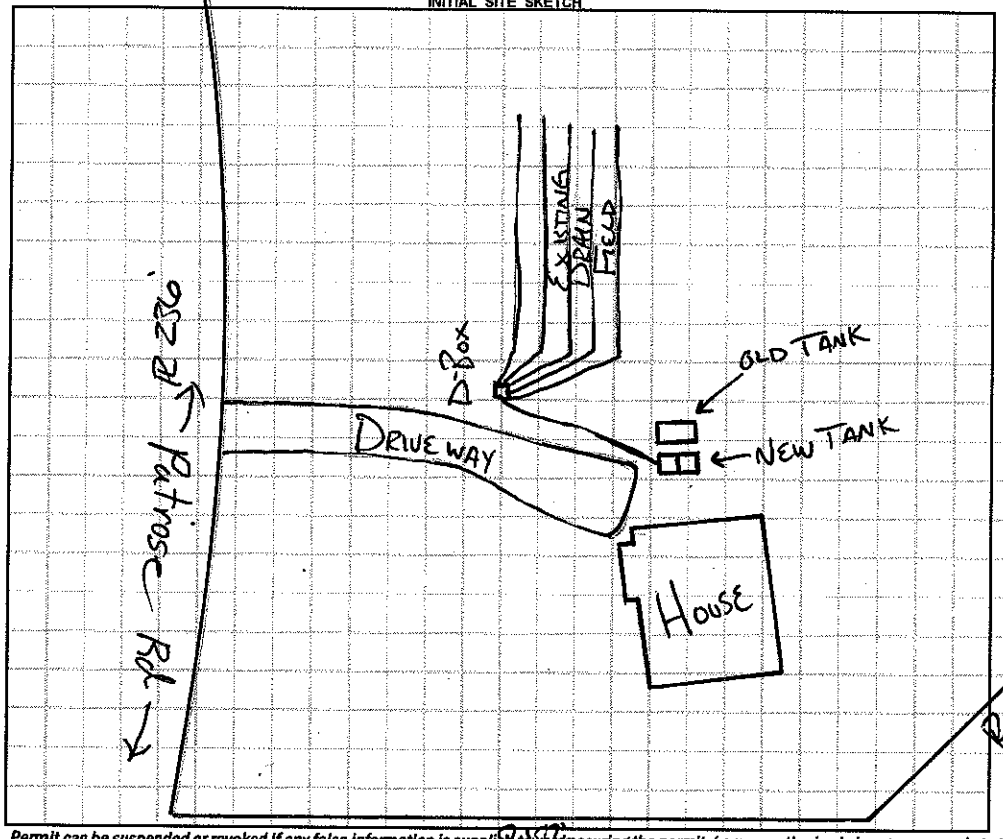

AS BUILT SKETCH

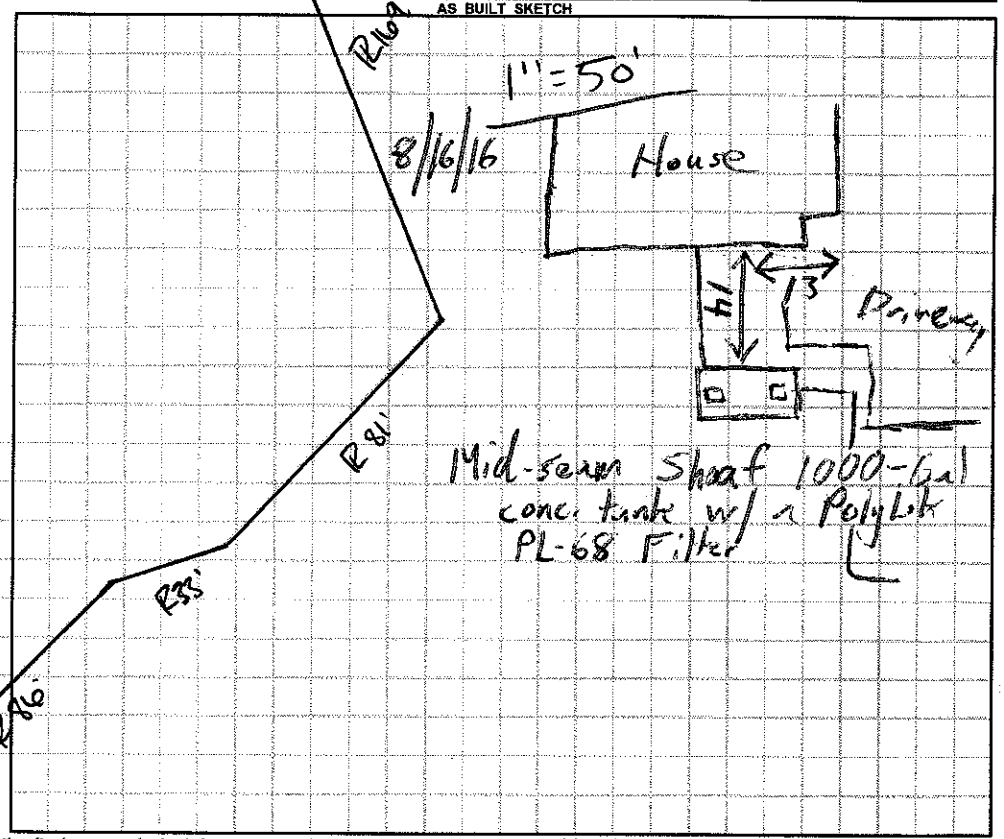

Permit can be suspended or revoked if any false information is supplied toward securing the permit / any unauthorized changes are made to the site / any unauthorized changes are made in the installation of the system. **CONTACT A LOCATOR SERVICE PRIOR TO ANY EXCAVATION**

☐ **IMPROVEMENT PERMIT** *with plat valid without expiration.* ☑ **IMPROVEMENT PERMIT** *with site plan valid for 60 mos.* ☒ **AUTHORIZATION TO CONSTRUCT** *valid for period equal to IMPROVEMENT PERMIT--not to exceed 60 mo.*

Owner / Applicant Signature: Betty Stiles Date: 8-12-16 Installed by: Lentz Septic (David Lentz)

IMPROVEMENT PERMIT by: RA Date: 8-12-16 OPERATION PERMIT by: Tom Shuck Date: 8-16-2016

AUTHORIZATION TO CONSTRUCT by: RA Date: 8-12-16 Existing System Inspected by: Date:

Health Dept. Copy - WHITE Applicant (Final Approval) - YELLOW Applicant (Conditional Approval) - PINK