# IREDELL COUNTY HEALTH DEPARTMENT Const. Auth. STATESVILLE 704-878-5305 MOORESVILLE 704-664-5281

## IMPROVEMENT PERMIT / ~~CERTIFICATE OF COMPLETION~~ / OPERATION PERMIT / EXISTING SYSTEM INSPECTION

PROPERTY DESCRIPTION NO. 24651 DATE Oct. 28, '97 TAX MAP NO. part of 1LA5 4658 21 1711 Watershed: ☑ Yes ☐ No

OWNER OR CONTRACTOR Ryan Financial Services PHONE: Business 664-3671 Home

ADDRESS 149 Yacht Cove Rd Mooresville

LOCATION 21 N. to L Valleyview TR Brooktree on left in curve

SUBDIVISION Oakbrooke BLOCK / SECTION LOT 72 / 88 LOT AREA 3.51 + .59 Ac SITE CLASS. PS DESIGN FLOW 360 gpd L.T.A.R. .3

Septic Tank: 1000 Gallons; STB 525 Date 5/1/98

Pump Tank: 1000 Gallons; PT 47 Date 5/8/98

Pump Make: Model Serial No.

Nitrification Field: No Fields 1 Square Feet 1200 Linear Feet 400

No Lines 6@67' Trench Width 36" Max Trench Bottom Depth 24" Gravel Depth 12"

☑ New System ☐ Repair System Type: I, II, (III), IV, V, VI (on 88)

System Description: pumped-pm- conventional on 88

Repair System Description: Same on Lot 88

Maintenance Agreement Required: ☐ Yes ☑ No

☑ House/Mod. Home No. Bedrooms 3

☐ Mobile Home No. Bathrooms 2

☐ Business No. Employees

☐ Other

☑ Slab ☐ Crawl Space ☐ Basement w/plumbing ☐ Basement wo/plumbing

Water Supply: ☑ Individual ☐ Community ☐ Public

Comments:

2" sch 40 supply can be used in place of 3" but will increase pump requirements


Comments:

86 10


8 10 10 Y - 10 6

9 11

INITIAL SITE SKETCH 1" = 100'

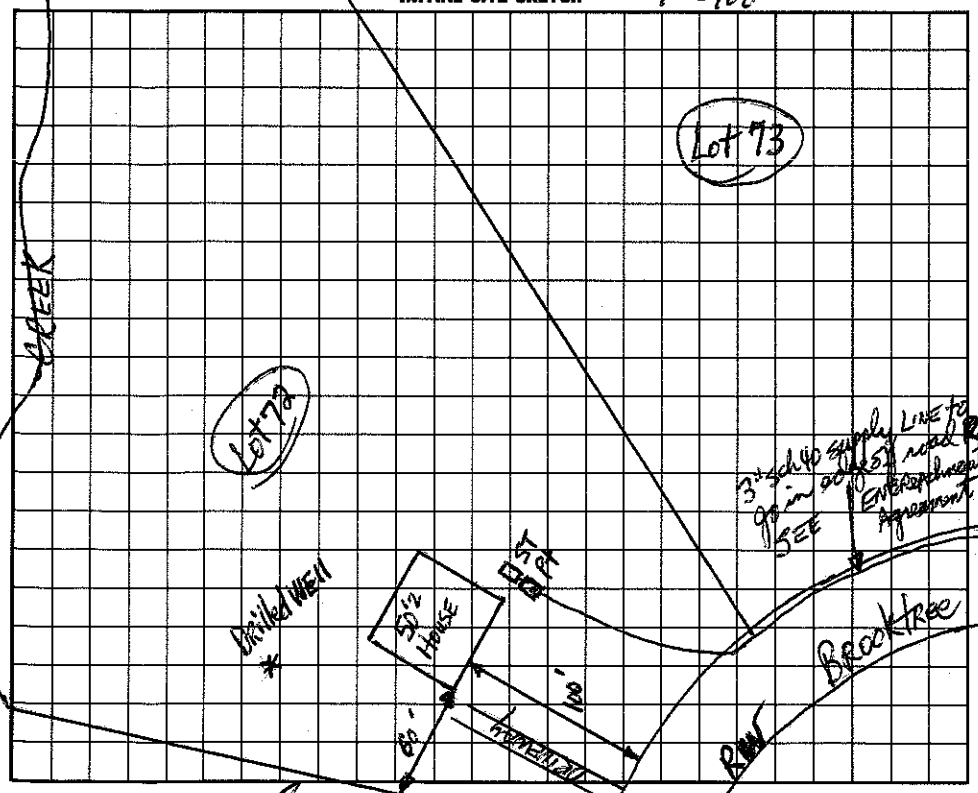


AS BUILT SKETCH

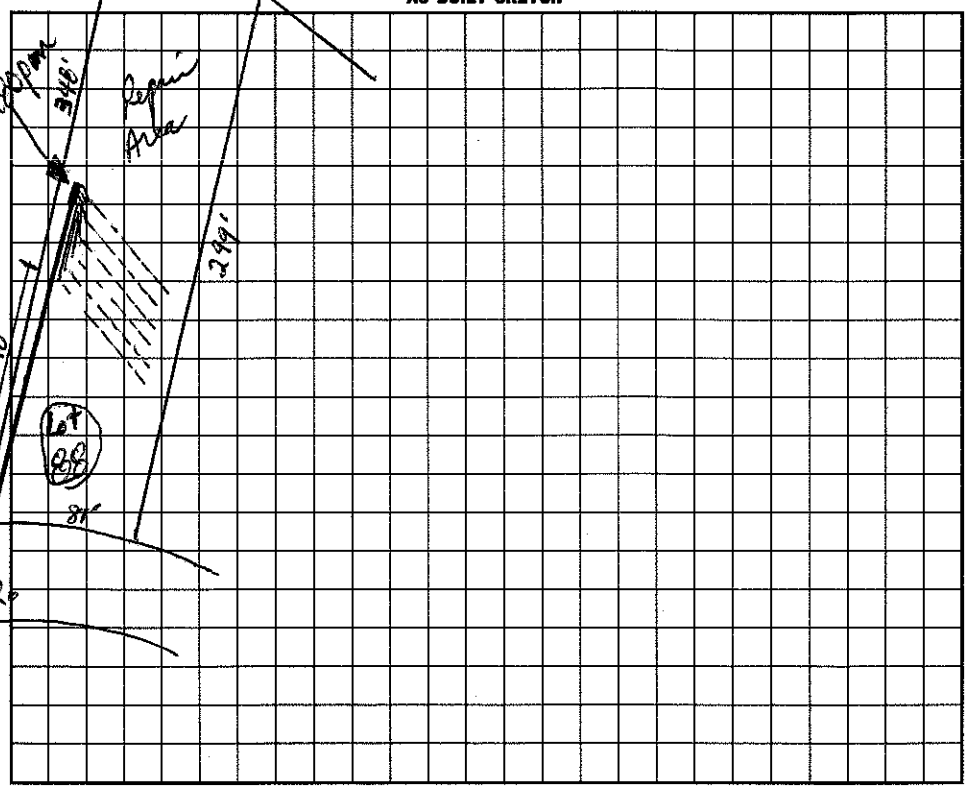


I understand that this permit can be suspended or revoked if any false information is supplied toward securing the permit/any unauthorized changes are made to the site/any unauthorized changes are made in the installation of the system. Improvement Permit is valid for 60 months from date of issuance.

Signed:

Improvement Permit by: RS date 10-28-97

Construction Authorization ~~Existing System Inspection~~ by: RS date 10-28-97

Installed by: ROWAN SEPTIC

Certificate of Completion by: Wesley Sparks RS date 9/23/98

Operation Permit by: Wesley Sparks RS date 9/23/98

HEALTH DEPT. COPY: WHITE INSPECTION COPY (FINAL): GREEN OWNER COPY (FINAL): YELLOW INSPECTION COPY (INITIAL): PINK OWNER COPY (INITIAL): GOLD