IREDELL COUNTY HEALTH DEPARTMENT Const. Auth STATESVILLE 704-878-5305 MOORESVILLE 704-664-5281

IMPROVEMENT PERMIT / ~~CERTIFICATE OF COMPLETION~~ / OPERATION PERMIT / EXISTING SYSTEM INSPECTION

PROPERTY DESCRIPTION NO. 24650 DATE Oct 14, 97 TAX MAP NO. part of 1LA5 4658 21 2485 Watershed: ☐ Yes ☐ No

OWNER OR CONTRACTOR Krom Financial Services PHONE: Business 664-3671 Home

ADDRESS 149 Yadkin Cove Rd Mooresville

LOCATION 2 1/2 N. TL Valleyview TR Brooktree on left 1st past Mayberry

SUBDIVISION Oaktrook BLOCK / SECTION LOT 71 LOT AREA 1.55Ac SITE CLASS. RS DESIGN FLOW 360gpd L.T.A.R. 1.3

Septic Tank: 1000 Gallons; STB 625 Date 7/11/98

Pump Tank: 1000 Gallons; PT 67 Date 10/1/98

Pump Make: Model Serial No.

Nitrification Field: No Fields 1 Square Feet 1200 Linear Feet 400

No Lines 4 @ 100' Trench Width 36" Max Trench Bottom Depth 18"

☑ New System ☐ Repair System Type: I, II, III, IV, V, VI

System Description: Pumped - pm Shallow conventional

Repair System Description: same

Maintenance Agreement Required: ☐ Yes ☑ No

Gravel Depth 12"

☑ House/Mod. Home No. Bedrooms 3

☐ Mobile Home No. Bathrooms 2

☐ Business No. Employees

☐ Other

☐ Slab ☑ Crawl Space ☐ Basement w/plumbing ☐ Basement wo/plumbing


Water Supply: ☑ Individual ☐ Community ☐ Public

Comments: Septic Installer Note Maximum trench bottom depth (18") =

Comments: Clemson type property fill triangle

1" = 100'

INITIAL SITE SKETCH

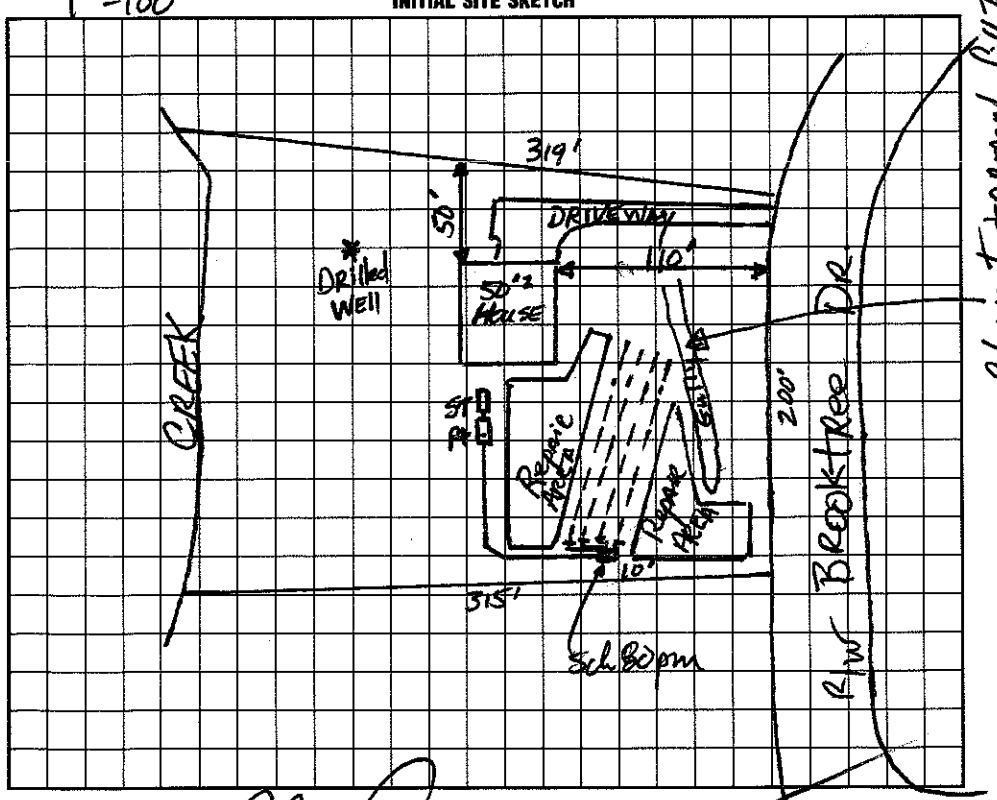

AS BUILT SKETCH

I understand that this permit can be suspended or revoked if any false information is supplied toward securing the permit/any unauthorized changes are made to the site/any unauthorized changes are made in the installation of the system. Improvement Permit is valid for 60 months from date of issuance.

Signed:

Improvement Permit by: DR Hinson RS date 10-14-97

Construction ~~Existing System Inspection~~ by: DR Hinson RS date 10-14-97

Authorization

Installed by: ROWAN SEPTIC

Certificate of Completion by: Maina H Dotson RS date 11/25/98

Operation Permit by: Maina H Dotson RS date 11/25/98

HEALTH DEPT. COPY: WHITE INSPECTION COPY (FINAL): GREEN OWNER COPY (FINAL): YELLOW INSPECTION COPY (INITIAL): PINK OWNER COPY (INITIAL): GOLD